



CERTIFIED LAND CORNER RESTORATION

Index No. **Y-25**

State of Wisconsin } ss.  
 County of Oneida

I Phillip T. Hansen do hereby certify that on the 7th day of April 1976, I found evidence of the S 1/16 corner of Section 31 and 36 Township 35 North, Range 10 and 11 East, Fourth Principal Meridian, as described hereon; and that from this evidence I established a new monument and accessories as described hereon to perpetuate the original location of this corner.

Resident witnesses:  
 Glen Barker  
 Jim Clafflin  
 Herb Jagoner

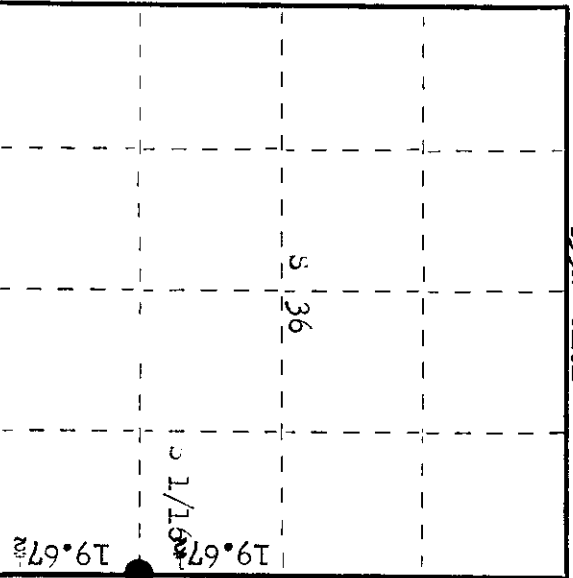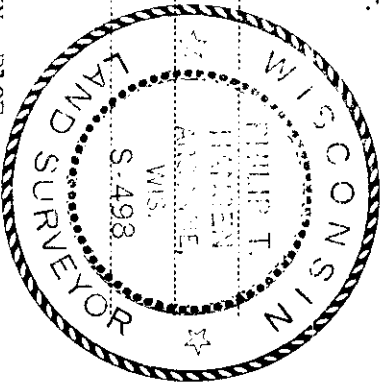

O = Corner monument restored.

History of original corner establishment: Corner established by H.C. Lawrence, registered Land Surveyor, in 1951. He ran a random line north along centerline of range line road from section Corner 31, 36, 1 and 6, a distance of 20.00 chains. Found an old wooden stake, not scribed, on west side of road. Continued north and at 39.25 chains found a post lying down near pile of stone. Unable to locate old point.  
 Set new S 1/16 Corner, as older post was too far north. Set 4" Cedar post, squared and scribed at 19.67 1/2 chains north of section Corner and distant between it and 1/4 Corner. Sets east side of road, 15 lks north of double telephone pole # 984-3/4 - 984 1/2.

Description of corner evidence found:  
 Recovered 4" cedar post, squared and scribed S 1/16 31, S 1/16 36 in poor condition. Small rock cairn built up around base.  
 No record of any BTS - The telephone poles mentioned above have been removed.

8  
9  
1  
2  
3  
5  
20

Description of monument and accessories I established to perpetuate the original location of this corner.  
 Removed 4" cedar post, replaced it with 1 1/2" x 4' iron pipe, projecting 2 ft. above ground. Placed a rock cairn around base. Set a 1 1/2" iron pipe with 2" brass cap for witness corner, 25 lks east. Pipe projects 2 ft. Cap stamped.  
 NETS - Hemlock 12" x 34' x 11.7 lks, scribed 1/16 BT.  
 Sugar 10" N 43° E 45 lks, scribed 1/16 BT.  
 Bearings and measurements made to true corner.  
 Pipe and BTS painted blue.

498  
 " - 25 lks  
 T35N R  
 10 36 | 31 11  
 " "C."  
 CFI-1976

Dated at Minnelanders Wis, this 12th day of July, 1976

Signature Phillip T. Hansen Title Registered Land Surveyor Registration No. S-498  
 (County Surveyor, Registered Land Surveyor, or other duly authorized official)

Office of Register of Deeds, County of Oneida  
 Instrument was filed in this office for record on the 23rd day of July, 1976 at 1:05 o'clock P.M.  
 I hereby certify that the within

Signature Thomas J. Kuchta  
 (Register of Deeds)

By \_\_\_\_\_ Deputy