

CERTIFIED LAND CORNER RESTORATION

Index No. Y-23

History of original corner establishment:

H.C. Lawrence, Registered Land Surveyor, ran the East-West 1/4 line and North-South 1/4 lines in 1951. Recovered an old post in a fence corner, origin unknown. Set a new cedar post at this location.

State of Wisconsin


County of Oneida } ss.

I Philip T. Hansen, do hereby certify that on the 3rd day of August, 19 79, I found evidence of the SC 1/16 corner of the Section 36 Township 35, North, Range 10 East, Fourth Principal Meridian, as described hereon; and that from this evidence I established a new monument and accessories as described hereon to perpetuate the original location of this corner.

Resident witnesses:

Jim Clafflin


Herb Wagoner

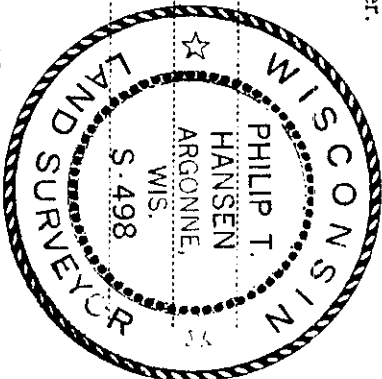

T35N R10E

S 36

SC 1/16

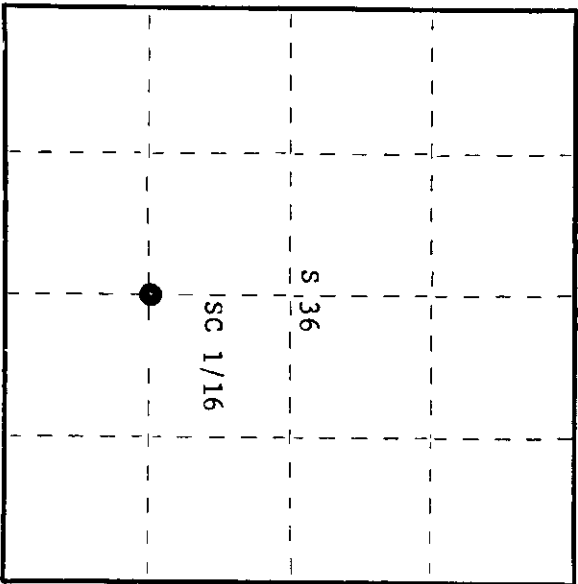

○ = Corner monument restored.

Description of corner evidence found:

Recovered Lawrence's 5" squared and scribed cedar post at an old fence corner, fences running south and east.

Recovered OBT's -

Sugar 11" N42°W 19.2 links, scribing partially legible.

Description of monument and accessories I established to perpetuate the original location of this corner.

Replaced wood post with 1-1/2" iron pipe with 2" brass cap, stamped:

Monument projects 18" above ground.

Marked NBT -

Sugar 7" S31°E 31.1 links, scribed 1/16 BT.

S498

T35N R10E

S 36

CPI-1979

Dated at Rhineland, Wis., this 7th day of August, 19 79

Signature Philip T. Hansen Title Registered Land Surveyor Registration No. S-498
(County Surveyor, Registered Land Surveyor, or other duly authorized official)

Office of Register of Deeds, County of Oneida 27th day of August, 19 79
at 10:00 clock M. August day of 1979
I hereby certify that the within instrument was filed in this office for record on the

Debra M. K...
(Register of Deeds)

By: Debra M. K... Deputy

3510361020