

CERTIFIED LAND CORNER RESTORATION

Index No. **X-25**



State of Wisconsin

County of Oneida } ss.

I Phillip T. Hansen do hereby certify that on the 7th day of April 1976, I found evidence of the quarter corner of Section 31 and 36 Township 35 North, Range 10 & 11 East, Fourth Principal Meridian, as described hereon; and that from this evidence I established a new monument and accessories as described hereon to perpetuate the original location of this corner.

Resident witnesses:

Glen Barker
Jim Claffin
Herb Wagoner

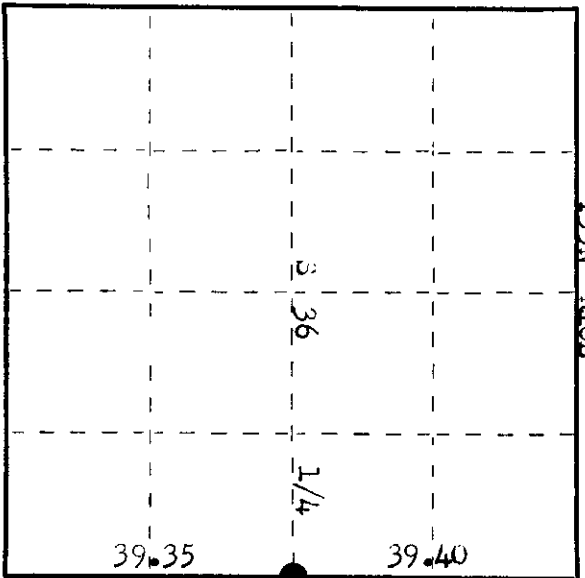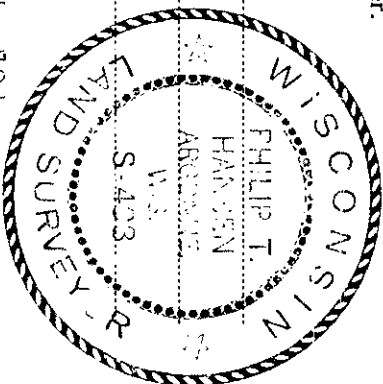

○ = Corner monument restored.

History of original corner establishment: Original corner established by Hiram C. Fellows, Deputy Surveyor, in 1859, from which cedar 10" bears N 65° 5 lks and Birch 12" bears S 86° 12 7 lks. Corner re-established by H.C. Lawrence, registered land surveyor, in 1924. Had a random line N 0° 30' along centerline of range line road, 39.35 chains. Found a post lying down near an old rock cairn. Unable to locate broken off joint. Set new cedar post in rock cairn. Continued north on same bearing at 78.75, intersected north line 59 lks west of Corner.

Description of corner evidence found: Recovered 4" cedar post, squared and scribed 1/4 S, S 31, R10E, 1/4 S 36 R10E, in poor condition. rock cairn around base and old squared, scribed stake laying on cairn.

No OBTs were recovered.

Description of monument and accessories I established to perpetuate the original location of this corner.
Replaced old 4" cedar post, with 2 1/2" iron pipe with brass cap stamped.
Pipe projects 2 ft. above ground.
BTS - Sugar 8" S 29° W, 20.4 lks, scribed 1/4 BT.
" Birch 12" S 85° W, 3.4 lks, scribed 1/4 BT.
Corner sets 1 chain north of end of range line road.
Monument and BTS painted blue.
Replaced rock cairn around base.

3498
T35N
R 10
E CPT-1976
R 36
E 31
R 11

Dated at Oneida, Wis., this 12th day of July, 1976.
Signature Phillip T. Hansen, Title Registered Land Surveyor, Registration No. S-498
(County Surveyor, Registered Land Surveyor, or other duly authorized official)

Office of Register of Deeds, County of Oneida, I hereby certify that the within instrument was filed in this office for record on the 25th day of July, 1976, at 10:00 o'clock A. M.

Debra Leverage Kuehn
(Register of Deeds)

By Phillip T. Hansen Deputy

0
0
0
0
36
2
0
0
3
5