

CERTIFIED LAND CORNER RESTORATION

Index No. **X-24**

History of original corner establishment: Corner established by H.C. Lawrence, registered Land Surveyor, in 1957. recovered old C 1/4 corner previously established of unknown origin. Ran random line N 89° 30' E on recent cut out line. at 41.70 chains intersected range line 16 lks south of 1/4 corner. Corrected bearing N 89° 17' E. set EC 1/16 corner at 8 lks north at 20.85 chains intermediate. 4" squared and scribed cedar post.



Description of corner evidence found: recovered 4" cedar post, squared and scribed EC 1/16 30, EC 1/16 336 in poor condition. an old 1 1/2" iron pipe was found beside it. Corner sets in old road bed of US Highway 45. No UBTs were recovered.

State of Wisconsin } ss.
County of Oneida

I, Phillip T. Hansen, do hereby certify that on the 8th day of April, 1976, I found evidence of the EC 1/16 corner of section 36 Township 35 North, Range 10 East, Fourth Principal Meridian, as described hereon; and that from this evidence I established a new monument and accessories as described hereon to perpetuate the original location of this corner.

Resident witnesses:

Glen Barker
Jim Claffin
Herb Hagoner

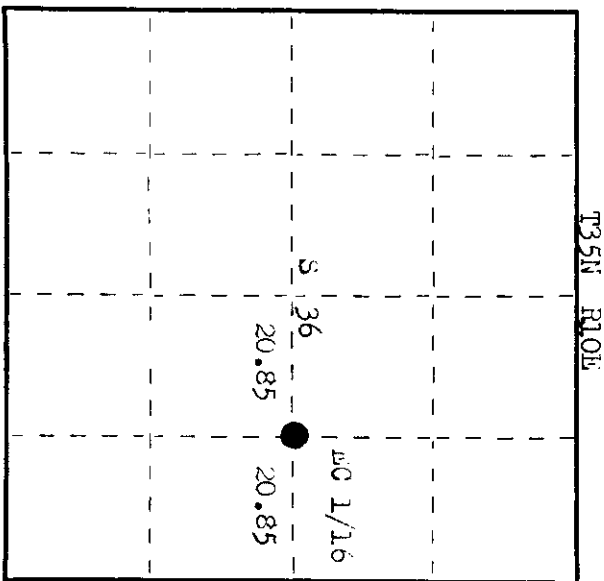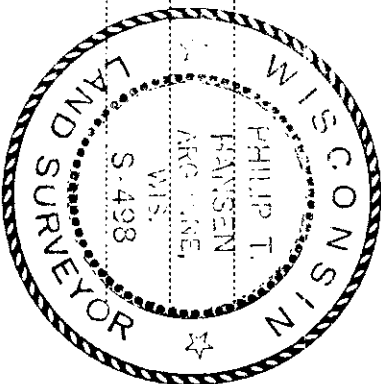

O = Corner monument restored.

Description of monument and accessories I established to perpetuate the original location of this corner. Replaced 4" cedar post with 1 1/2" iron pipe with brass cap stamped. Monument projects 2 ft. above ground. Placed rock cairn around base. as this is all in open area, two witness monuments were set.

1 - 1 1/2" x 5' iron pipe S 45° E 50 lks. EC 1/16 36
2 - 1 1/2" x 5' iron pipe N 45° E 50 lks. CPI - 1976
Monuments project 2' above ground. All pipes painted blue.

Dated at Rhineland, Wis., this 12th day of July, 1976.
Signature: *Phillip T. Hansen* Title: registered Land Surveyor Registration No. S-498
(County Surveyor, Registered Land Surveyor, or other duly authorized official)

Office of Register of Deeds, County of Oneida, I hereby certify that the within instrument was filed in this office for record on the 23rd day of July, 1976 at 10:00 o'clock P.M.

Deirdre Lehage Kuehn
(Register of Deeds)

By: Deputy

3510362010