



CERTIFIED LAND CORNER RESTORATION

Index No. **X-22**

State of Wisconsin }  
 County of Oneida } ss.

I, Philip T. Hansen, do hereby certify that on the 28th day of April, 1976, I found evidence of the WC 1/16 corner of Section 36 Township 10 North, Range 35, Fourth Principal Meridian, as described hereon; and that from this evidence I established a new monument and accessories as described hereon to perpetuate the original location of this corner.

Resident witnesses:  
 Glen Barker  
 Jim Clarlin  
 Herb Wagoner

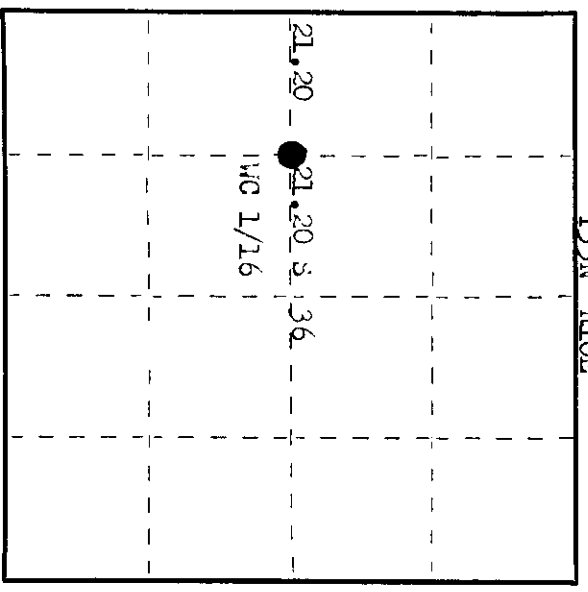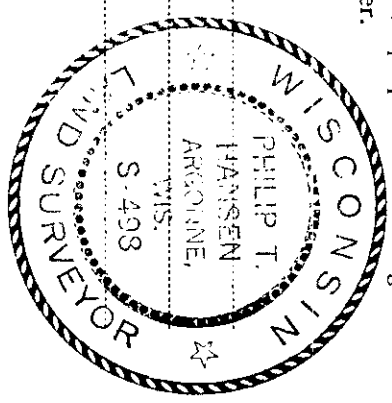

○ = Corner monument restored.

History of original corner establishment: Corner established by H.C. Lawrence, Registered Land Surveyor, in 1957. From recovered C 1/4 corner of unknown origin he ran West 42.40 chains to intersect the line between Section 35 and 36 at a point 70 lks North of 1/4 Corner. Set WC 1/16 Corner at 21.20 chains, South 35 lks e distant. Corrected bearing of line S 88° 33' W.

Set 4" cedar post, but does not mention any BTs.

Description of corner evidence found:  
 Recovered 4" cedar post, squared and scribed WC 1/16 S 36, 336 WC 1/16.  
 Post was in poor condition.  
 Rock cairn built around base of post.  
 Recovered BTs - Maple 9" S 54° 0" 19.3 lks, scribed 336 BT.  
 " Birch 12" N 4° 0" 54.3 lks, scribed WC 1/16 BT.

Description of monument and accessories I established to perpetuate the original location of this corner.  
 Replaced 4" cedar post with 1 1/2" iron pipe with 2" brass cap stamped.  
 Pipe projects 18" above ground.  
 BT - Sugar 7" N 35° 0" 16.4 lks, scribed 1/16 BT.  
 Monument and BTs painted blue.  
 Replaced rock cairn around base.

3498  
 T35N R10E  
 WC 1/16 S 36  
 CFI-1976

Dated at Oneida, Wis., this 16th day of July, 1976.  
 Signature: *Philip T. Hansen* Title: Registered Land Surveyor Registration No. S-498  
 (County Surveyor, Registered Land Surveyor, or other duly authorized official)

Office of Register of Deeds, County of Oneida  
 Instrument was filed in this office for record on the 23rd day of July, 1976 at 10:00 o'clock M.

*Doris George Kuehn*  
 (Register of Deeds)

By: \_\_\_\_\_ Deputy

9 3 0 2 2 0 3 3 5 1 0 1 5