

CERTIFIED LAND CORNER RESTORATION

Index No. **W-23**

State of Wisconsin } ss.  
County of Oneida


History of original corner establishment: Corner established by H.C. Lawrence, registered land surveyor, in 1957, set 4" squared cedar post equidistant between C 1/4 and N 1/4 Corner. No record of any BTs established.

I Philip T. Hansen, do hereby certify that on the 5th day of April, 1976, I found evidence of the NE 1/4 corner of the Section 36 Township 35, North, Range 10 East, Fourth Principal Meridian, as described hereon; and that from this evidence I established a new monument and accessories as described hereon to perpetuate the original location of this corner.

Description of corner evidence found: Recovered 4" cedar post, squared and scribed NE 1/4 336 in fair condition.  
Recovered OPTE - Sugar 15" S 88° W 45 lks, scribed 330 SF.  
Recovered 12" due North, 25.7 lks, scribed NE 1/4 336 SF.  
No other available for these BTs.


Resident witnesses:

Glen Barker  
Jim Claffin  
Herb Jaeger

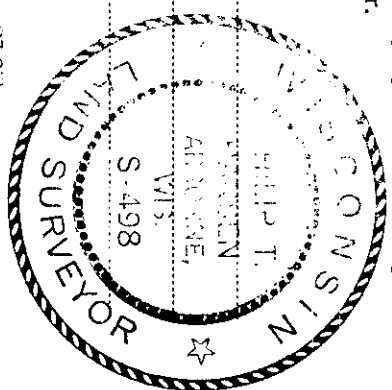

Description of monument and accessories I established to perpetuate the original location of this corner.  
Replaced 4" cedar post with 1" OD iron pipe with 2" brass cap scribed.  
Pipe projects 18" above ground.  
BPT - Wash 9" S 50° E 43.8 lks, scribed NE 1/4 336.  
Corner sets approximately 3 chains east of BPT.  
Pipe and BPTs painted blue.

3498  
35N 310E  
10 1/16 S 136  
DIT - 1976

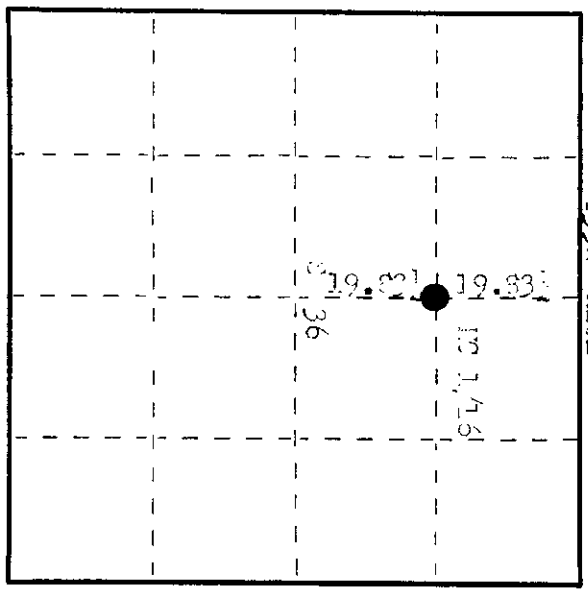

O = Corner monument restored.

Dated at Rhinelander, Wis, this 6th day of July, 1976.

Signature Philip T. Hansen Title Registered Land Surveyor Registration No. 498  
(County Surveyor, Registered Land Surveyor, or other duly authorized official)

Office of Registrar of Deeds, County of Oneida, I hereby certify that the within instrument was filed in this office for record on the 23rd day of July, 1976 at 100 o'clock P. M.

Dorcas M. Berger  
(Register of Deeds)

By Dorcas M. Berger Deputy

3510363020