

CERTIFIED LAND CORNER RESTORATION



Index No. **E-23**

State of Wisconsin

County of Oneida } ss.

I Philip T. Hansen do hereby certify that on the 22nd day of May, 1975, I found evidence of the Sections 1 and 12 corner of Township 35 North, Range 11 East, Fourth Principal Meridian, as described hereon; and that from this evidence I established a new monument and accessories as described hereon to perpetuate the original location of this corner.

Resident witnesses:

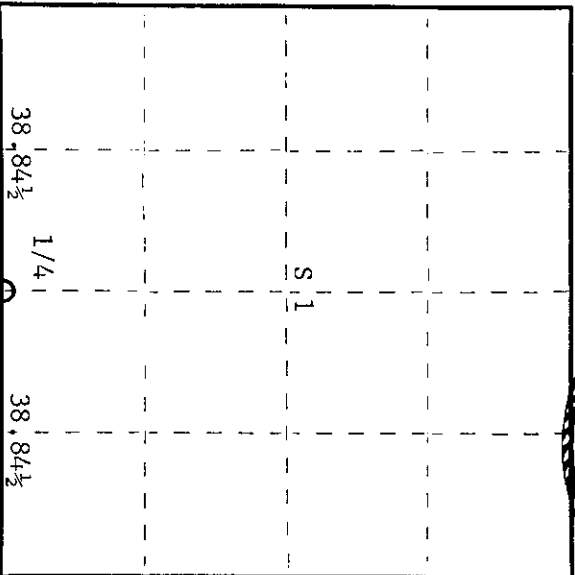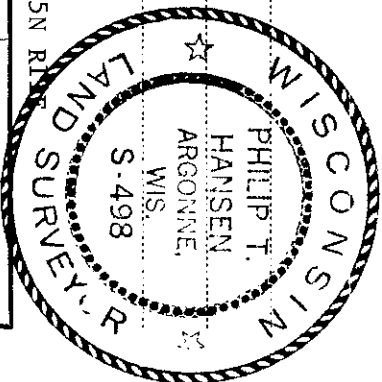

○ = Corner monument restored.

History of original corner establishment:

Original corner established by Wm. E. Dougherty, Gov. Deputy Surveyor, in 1859, from which aspen 9" bears N63°E 18 links, and cherry 7" bears S76°W 26 links. Corner restored in 1914 by D.H. Vaughan, County Surveyor. He made no mention of finding this 1/4 corner. Marked hemlock 14" N70 1/2°E 44 links, and sugar 8" S71 1/2°W 40 links. Corner re-established by H.C. Lawrence, Registered Land Surveyor, in 1957, during his retracement survey. He set the corner at Vaughan's. Calls 38.84 1/2 equidistant. A 4" cedar post, from which basswood 20" bears S46°W 62 links, and hemlock 16" bears S32°E 72 links.

Description of corner evidence found:

Recovered 4" cedar post, squared and scribed 1/2 S S1; 1/2 S S12, in poor condition. Also, 1 1/2" iron pipe set beside it.

Recovered OBT basswood 20" (24) S46°W (S34°W) 62 links, scribing half grown over, and hemlock 16" (18) S32°E (S29°E) 72 links, scribed 1/2 S B1.

Description of monument and accessories I established to perpetuate the original location of this corner.

Replaced 4" cedar post with 2 1/2" iron pipe with brass cap stamped -

S498  
T35N R11E

1/4 S | 1  
S | 12

CPI-1975

Dated at Rhinelander, Wis., this 10th day of June, 1975.

Signature *Philip T. Hansen* Title Registered Land Surveyor Registration No. S-498  
(County Surveyor, Registered Land Surveyor, or other duly authorized official)

Office of Register of Deeds, County of Oneida  
Instrument was filed in this office for record on the 1st day of October, 1975, at 3:00 o'clock P.M.

*Dona Verge Faeber*  
(Register of Deeds)

By: Deputy

3511010020