

CERTIFIED LAND CORNER RESTORATION

Index No. D-25

State of Wisconsin

County of Oneida } ss.

I Phillip T. Hansen, do hereby

certify that on the 11th day

of August, 1975, I found

evidence of the S-1/16

corner of Sections 1 and 6

Township 35, North, Range


11 East, Fourth Principal Meridian,

as described hereon; and that from this evidence

I established a new monument and accessories

as described hereon to perpetuate the original

location of this corner.

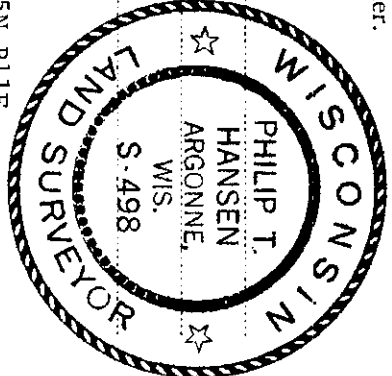

Resident witnesses:

Glen Barker

Jim Clafflin

History of original corner establishment:
 Corner recovered by H.C. Lawrence, Registered Land Surveyor, in 1946. Recovered wood post in fence line scribed 1/8, origin unknown. Distance north of SE Corner Section 1 is 20.12 chains. No BT's were found.


Description of corner evidence found:

Recovered cedar stake badly decayed, but scribe marks 1/8 found legible on two sides sitting in North-South fence line. Recovered the old point in ground 1 link south of the fence corner.

Description of monument and accessories I established to perpetuate the original location of this corner.

Replaced old point with 1-1/2" OD iron pipe w/2" brass cap stamped -

NBT's marked: Sugar 10" S80°W 52.2 links-scribed 1/16 BT R
 Basswood 10" N25°E 30.1 links-scribed 1/16 BT E
 S-1/16 R
 CPT-1975

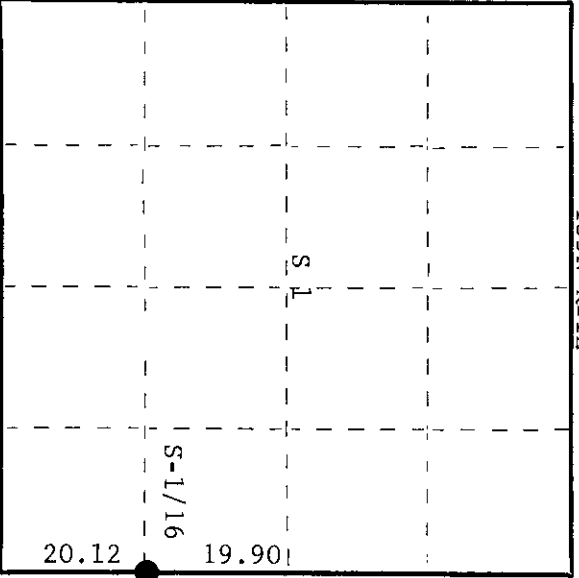

○ = Corner monument restored.

Dated at Rhineland, Wis., this 5th day of August, 1975.

Signature Phillip T. Hansen Title Registered Land Surveyor Registration No. S-498
 (County Surveyor, Registered Land Surveyor, or other duly authorized official)

Office of Register of Deeds, County of Oneida
 Instrument was filed in this office for record on the 14th day of October, 1975
 at 2:00 o'clock P.M.

Doris Verage Fuchs
 (Register of Deeds)

By: _____ Deputy

3511011000