


CERTIFIED LAND CORNER RESTORATION


Index No. D-23

State of Wisconsin }
 County of Oneida } ss.

I Phillip T. Hansen, do hereby certify that on the 22nd day of May, 1975, I found evidence of the SC-1/16 corner of Section 1 Township 35, North, Range 11 E, Fourth Principal Meridian, as described hereon; and that from this evidence I established a new monument and accessories as described hereon to perpetuate the original location of this corner.

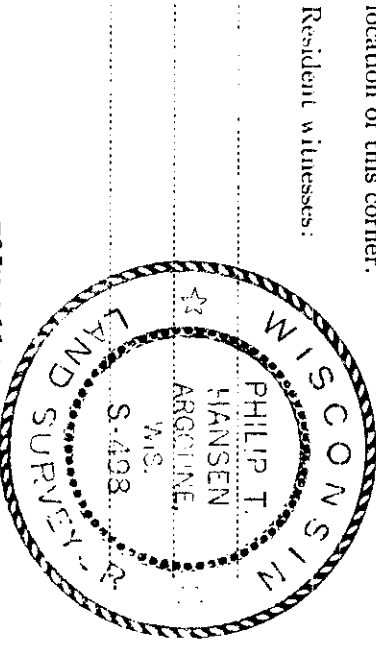

Resident witnesses:

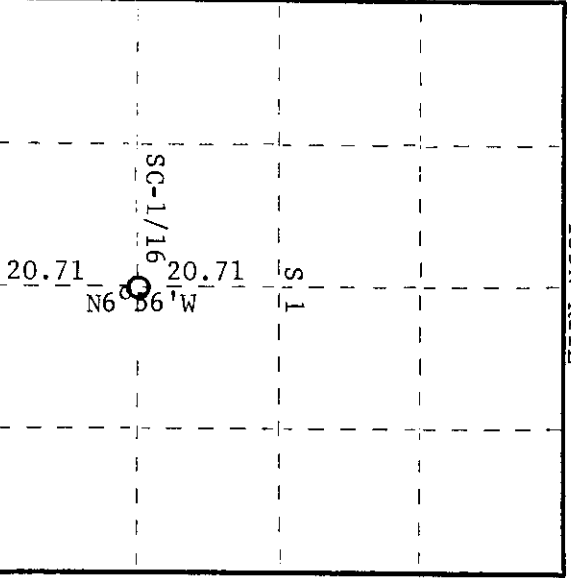

○ = Corner monument restored.

History of original corner establishment:

Corner established by H.C. Lawrence during his retracement survey in 1957. Corner was set 20.71 chains north of S-1/4 corner, 20.71 chains south of C-1/4 corner. Set a 3" cedar post witnessed by a sugar 16", N55°0'W, 6 links. This sugar had an old blaze on the south side and there was barbed wire fastened to it for a fence line many years ago. No fence posts were in evidence.

Description of corner evidence found:

Recovered 3" cedar post, squared and scribed SC-1/16 S1; SC-1/16 S1 in good condition. Recovered OBT:

Sugar 16" N55°0'W 6 links, dead but still standing scribed BR

Description of monument and accessories I established to perpetuate the original location of this corner.

Replaced 3" cedar post with 1-1/2 OD iron pipe w/2" brass cap stamped -

NBT's:

White birch 6" S71°E 30.2 links
 White birch 7" S5°0'W 41 links scribed 1/16BR
 S498
 T35N R11E
 SC-1/16 S1
 CPL-1975

Dated at Rhineland, Wis., this 9th day of June, 1975.

Signature Phillip T. Hansen Title Registered Land Surveyor Registration No. S-498
 (County Surveyor, Registered Land Surveyor, or other duly authorized official)

Office of Register of Deeds, County of Oneida
 Instrument was filed in this office for record on the 1st day of October, 1975 at 3:00 o'clock P.M.

Doris Verage Kuehn
 (Register of Deeds)

By: _____ Deputy

3511011020