

CERTIFIED LAND CORNER RESTORATION

Index No. **C-22**

State of Wisconsin





Resident witnesses:



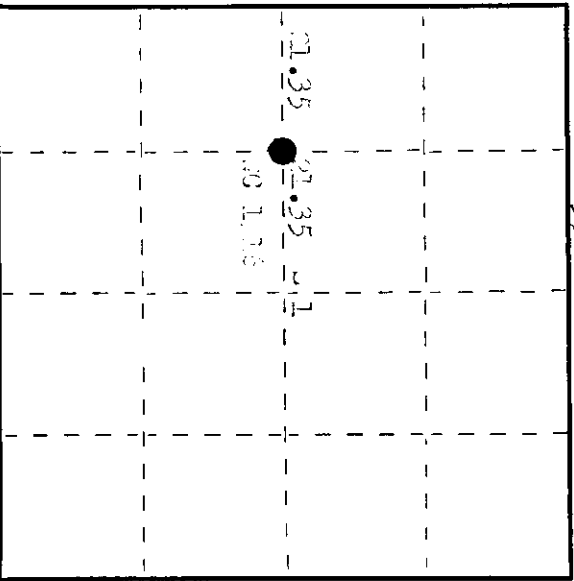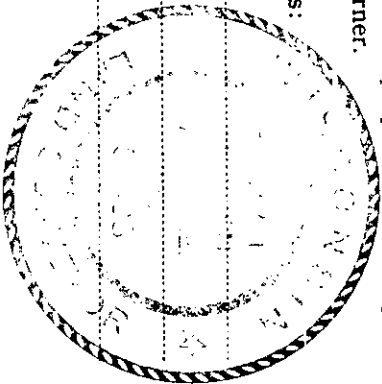

○ = Corner monument restored.

History of original corner establishment:


Description of corner evidence found:




101.106 + 1  
101.107  
 01-1-79

Dated at Waushara, Wis., this 11th day of September, 1979.

Signature Phillip G. Stamm, Title County Surveyor, Registration No. ...  
 (County Surveyor, Registered Land Surveyor, or other duly authorized official)

Office of Register of Deeds, County of Waushara, I hereby certify that the within instrument was filed in this office for record on the 7th day of December, 1976, at 11:02 o'clock A.M.

Dawn Therese Truchan  
 (Register of Deeds)

By Joseph M. Stamm Deputy

3511012030