

CERTIFIED LAND CORNER RESTORATION

Index No. **B-25**

State of Wisconsin


County of Oneida } ss.

History of original corner establishment:
 Corner recovered (unknown origin) by John Macon, Consolidated Forester, in 1946. This was a squared wooden post scribed 1/8-1/8, set in a clump of small balsam. This is 58.13 chains north of SE corner of Section 1.

I Phillip T. Hansen, do hereby certify that on the 11th day of August, 1975, I found evidence of the N-1/16 corner of Sections 1 and 6 Township 35 North, Range 11 and 12 East, Fourth Principal Meridian, as described hereon; and that from this evidence I established a new monument and accessories as described hereon to perpetuate the original location of this corner.

Resident witnesses:

Glen Barker
Jim Clafflin

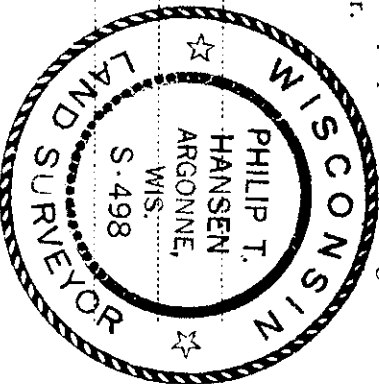


Description of corner evidence found:
 Recovered 4" cedar post, squared and scribed 1/8-1/8, in poor condition. No BT's were recovered. No records on file in either Forest County or Oneida County records. Based on original length of line and based on proportionate measurements, this corner should be 1.48 chains south of its present location but, because of length of time it has been accepted as the corner, 29 years plus, it was not reset.

Description of monument and accessories I established to perpetuate the original location of this corner.
 Replaced 4" cedar post with 1-1/2" OD iron pipe w/2" brass cap stamped -

NBT's: Black spruce 6" N23°W 20.7 links - scribed 1/16 BT
 White spruce 6" S34°E 20.7 links - scribed 1/16 BT

R	11	S1	S6	12	R
E					E

N-1/16
 CPT-1975

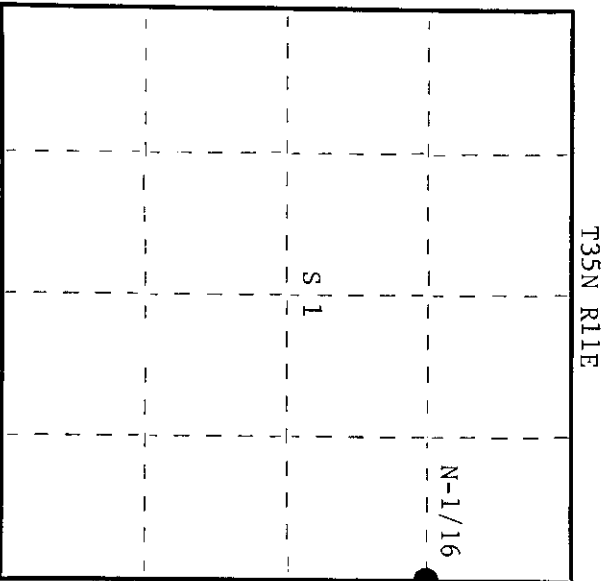

○ = Corner monument restored.

3511013000

Dated at Rhineland, Wis., this 4th day of September, 1975.
 Signature: Phillip T. Hansen Title: Registered Land Surveyor Registration No. S-498
 (County Surveyor, Registered Land Surveyor, or other duly authorized official)

Office of Register of Deeds, County of Oneida
 Instrument was filed in this office for record on the 14th day of October 1975
 at 3:00 o'clock P. M.

Doris George Kuehn
 (Register of Deeds)

By: _____ Deputy