



CERTIFIED LAND CORNER RESTORATION

Index No. **E-21**

State of Wisconsin } ss.
 County of Oneida }

I Philip T. Hansen do hereby certify that on the 10th day of July 1975 I found evidence of the Section corner corner of S1, S2, S11, S12 Township 35 North, Range 11 East, Fourth Principal Meridian, as described hereon; and that from this evidence I established a new monument and accessories as described hereon to perpetuate the original location of this corner.

Resident witnesses:

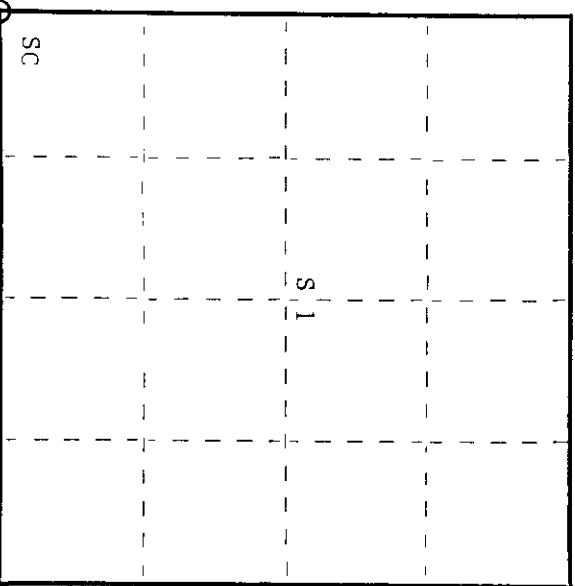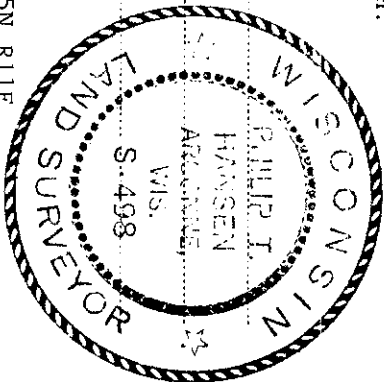

○ = Corner monument restored.

History of original corner establishment:

Original corner established by Wm. E. Dougherty, Gov. Deputy Surveyor, in 1859, from which tamarack 8" bears N76°W 19 links, and tamarack 9" bears S50°E 15 links. H.C. Lawrence, Registered Land Surveyor, recovered this corner in 1957, during his retracement survey. He recovered the old post, original tamarack N76°W, and the stump of original tamarack S50°E with no marks visible. Lawrence set a new 5" cedar post and marked NBT's - cedar 6" N75°E 34½ links, and cedar 4" S52°E 59½ links.

Description of corner evidence found:

Recovered 5" cedar post, squared and scribed S1, S2, S11, S12, in poor condition. Also a 3" squared cedar stake lying beside Lawrence's.
 Recovered OBT's - cedar 6" (7") N75°E (N79°E) 34.5 links Scribed S1 NBT.
 Cedar 4" (5") S52°E (S50°E) 59.5 links Scribed S12 NBT.

Description of monument and accessories I established to perpetuate the original location of this corner.

Replaced 5" cedar post with 2½" iron pipe with brass cap stamped -

NBT - cedar 5" N32°E 28.3 links Scribed SC BT.

S498

T35N R11E	
S2 S1	
S11 S12	

CPT-1975

Dated at Rhinelander Wis. this 24th day of July 1975

Signature *Philip T. Hansen* Title Registered Land Surveyor Registration No. S-498.
 (County Surveyor, Registered Land Surveyor, or other duly authorized official)

Office of Register of Deeds, County of Oneida
 instrument was filed in this office for record on the 1st day of October 1975 at 3:00 o'clock P.M.

Lorne Lange Kuehn
 (Register of Deeds)

By Deputy

3511026000