

CERTIFIED LAND CORNER RESTORATION

Index No. **E-19**



State of Wisconsin


I, John J. ..., do hereby certify that on the 12th day of October, 1976, I found evidence of the North corner of Section 11, Township 25, North, Range 11, East, Fourth Principal Meridian, as described hereon; and that from this evidence I established a new monument and accessories as described hereon to perpetuate the original location of this corner.



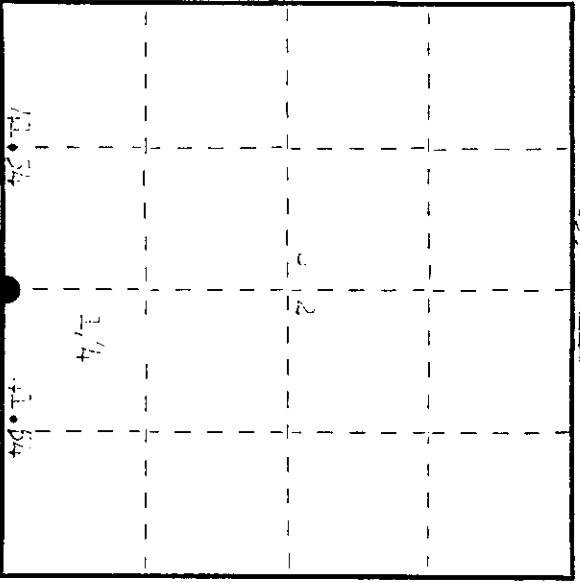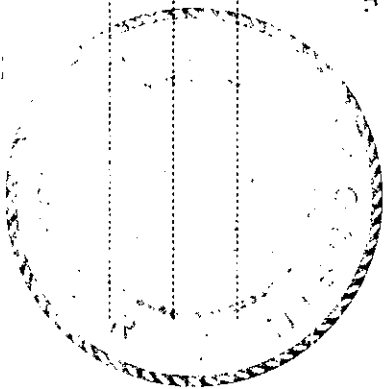

○ = Corner monument restored.

History of original corner establishment:

 Description of corner evidence found:  

Description of monument and accessories I established to perpetuate the original location of this corner.

 1/4  
 8.1-1976


Signature: John J. ... Title: Registered Land Surveyor Registration No. 27728  
 (County Surveyor, Registered Land Surveyor, or other duly authorized official)

 Instrument was filed in this office for record on the 12th day of December, 1976 at 11:02 o'clock A. M.

Doris Teresa Kuehn  
 (Register of Deeds)

