

CERTIFIED LAND CORNER RESTORATION

Index No. **D-21**

State of Wisconsin

County of Waushara } ss.


I, William A. Hanson, do hereby certify that on the 2nd day of November, 1975, I found evidence of the 1/16 corner of the Section 1 Township 35, North, Range 11 East, Fourth Principal Meridian, as described hereon; and that from this evidence I established a new monument and accessories as described hereon to perpetuate the original location of this corner.

Resident witnesses:


John Hanson

John Hanson

Hereafter

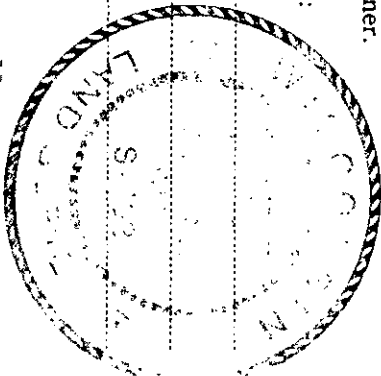

1954-11-11

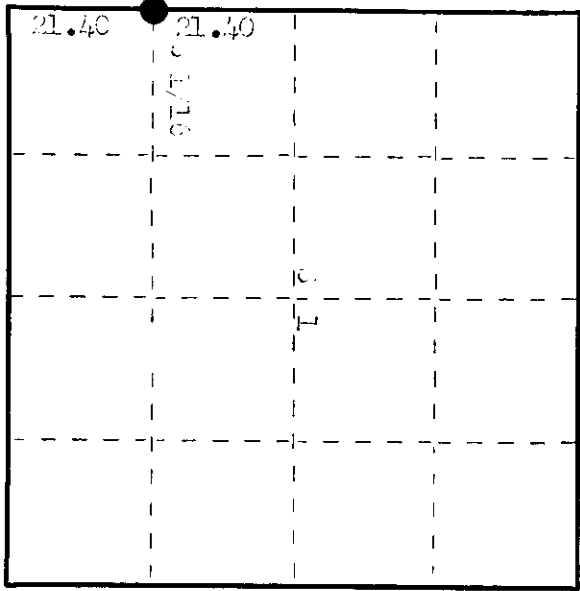

○ = Corner monument restored.

History of original corner establishment:



Description of corner evidence found:




Dated at Waushara, Wis., this 2nd day of November, 1975.

Signature John Hanson Title Surveyor Registration No. 2-423
 (County Surveyor, Registered Land Surveyor, or other duly authorized official)

Office of Register of Deeds, County of Waushara, I hereby certify that the within instrument was filed in this office for record on the 7th day of December, 1976 at 10:00 o'clock A. M.

Dana Savage Kuehn
 (Register of Deeds)

By Joseph M. Brown Deputy

351102/1000