

CERTIFIED LAND CORNER RESTORATION

Index No. **E-13**

State of Wisconsin




and that from this evidence I established a new monument and accessories as described hereon to perpetuate the original location of this corner.

Resident witnesses:

John J. ...

...

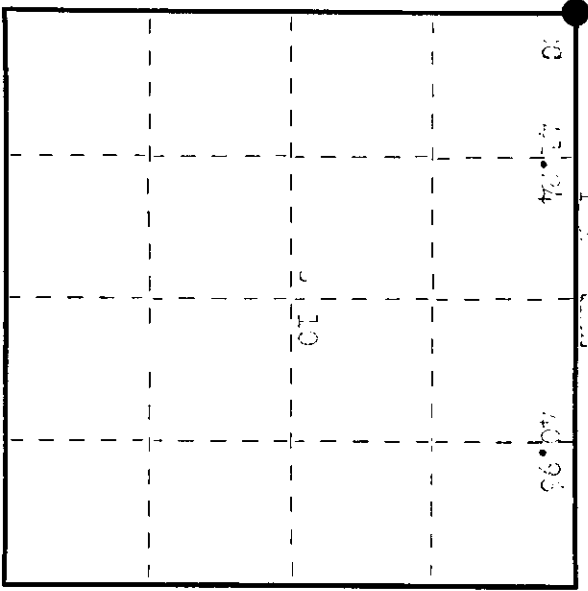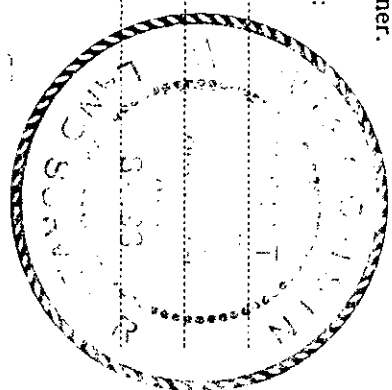

○ = Corner monument restored.

History of original corner establishment:

Original corner established by ... in 1976. ...

Description of corner evidence found:

Recovered ... 1976. ...

Description of monument and accessories I established to perpetuate the original location of this corner.

... 1976. ...


Signature Philip Stamm Title Surveyor Registration No. 478
(County Surveyor, Registered Land Surveyor, or other duly authorized official)


Doris Savage Kuehn
(Register of Deeds)

By Joseph M. ... Deputy