

State of Wisconsin

County of **Oneida**

ss.

I **Phillip T. Hansen**

certify that on the **3rd** day

of **November**, 19 **76**, I found

evidence of the **Section**

corner of **4, 5, 8, 9**

Township **35**

**II**, North, Range

**II**, Fourth Principal Meridian,


as described hereon; and that from this evidence I established a new monument and accessories as described hereon to perpetuate the original location of this corner.

Resident witnesses:


**Glenn Barker**

**Jim Claflin**

**Herb Wagoner**

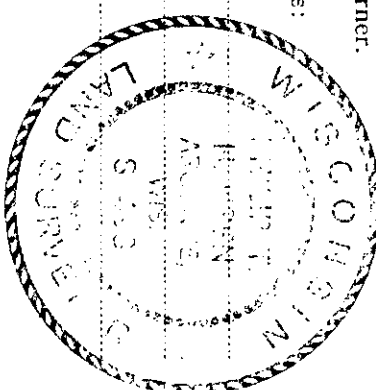

T35N R11E

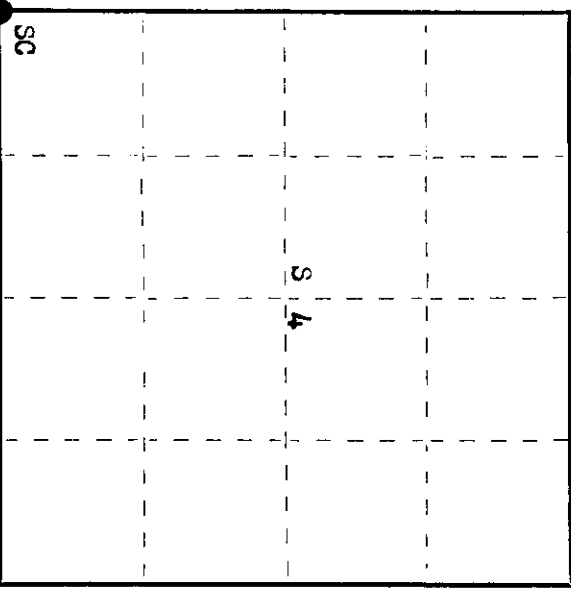

○ = Corner monument restored.

History of original corner establishment:

Original Corner established by Wm. E. Dougherty, Deputy Surveyor, in 1859, from which White Birch 10" bears N 55° E 16 links and White Birch 12" bears S 66° W 27 links. H.C. Lawrence, Registered Land Surveyor, set this corner by proportional measurement. From recovered corner Sec. 8, 9, 16 and 17 ran a random line North (mag.) 39.34 chains, at which original 1/4 corner is 15 links due west. Continued on same line at 39.34, set 4" cedar post 30 links west, assuming corner to be on straight line. Set 4" cedar post and marked NBTs - E1m 18" S 45° W 118 links and dug well, N 68° E 98 links.

Description of corner evidence found:

Recovered 4" cedar post, squared and scribed S4, S5, S8, S9, with rock cairn around it. Post is in poor condition.  
Recovered OBT - E1m 18" S 45° W 1.18 chains, scribed S8 BT.

Description of monument and accessories I established to perpetuate the original location of this corner.

Replaced cedar post with 2 1/2" Berntsen A-1 Federal Monument, aluminum with magnet installed in cap and base. Cap stamped:  
Monument projects 18" above ground. T35N R11E  
Replaced rock cairn around base. Sec. 5 1/4  
NBTs - Red Pine 8" S 19° E 2.755 chains, scribed SC BT. 8 1/9  
Red Pine 6" S 34° E 2.518 chains, scribed SC BT. S498-1976

Dated at **Rhineland**, Wis., this **29th** day of **November**, 19**76**

Signature: *Phillip T. Hansen* Title: **Registered Land Surveyor** Registration No. **S-498**  
(County Surveyor, Registered Land Surveyor, or other duly authorized official)

Office of Register of Deeds, County of **Oneida**, I hereby certify that the within instrument was filed in this office for record on the **23rd** day of **March**, 19**77** at **3:00** o'clock **P.**M.

*Dorothy H. Hage* *Karen Hage*  
(Register of Deeds)

By: \_\_\_\_\_ Deputy

3511050000