

CERTIFIED LAND CORNER RESTORATION



Index No. **E-7**

State of Wisconsin }  
County of Oneida } ss.

I Phillip T. Hansen, do hereby certify that on the 10th day of November, 1976, I found evidence of the Quarter corner of Section 5 & 8 Township 25, North, Range 11 East, Fourth Principal Meridian, as described hereon; and that from this evidence I established a new monument and accessories as described hereon to perpetuate the original location of this corner.

Resident witnesses:

Glen Barker  
Jim Claffin  
Herb Hagoner

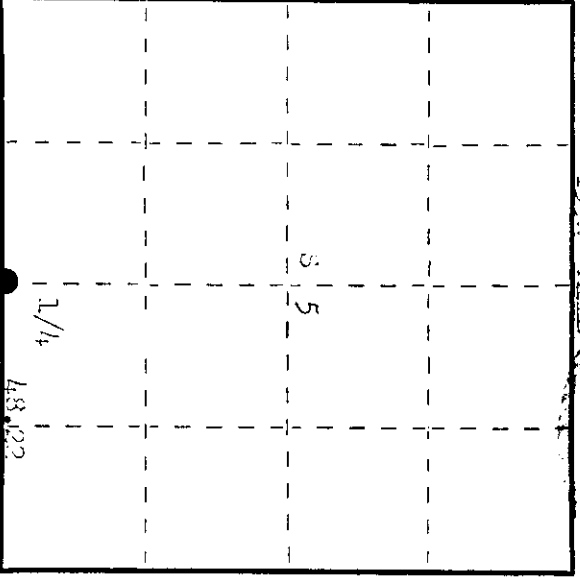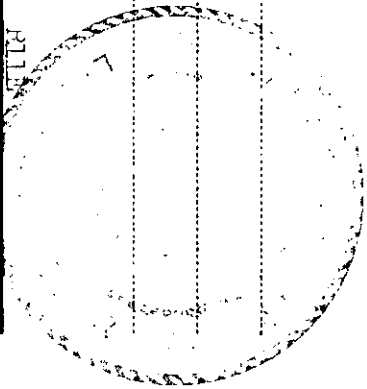


○ = Corner monument restored.

History of original corner establishment:

Original corner established by Wm. W. Dugan, Deputy Surveyor, in 1859 from which Tamarack 14" bears a 80° ± 18 links and Lawrence's 3" bears a 150° ± 27 links. J.H. Hansen, County Surveyor, recovered this corner and W. W. Lane also recovered this corner. Set an iron pipe with brass cap in 1940. H.O. Lawrence, registered land surveyor, recovered this corner in 1954. He found Lane's iron pipe and an old burned wooden post. Set a new 4" cedar post.

Description of corner evidence found:

Recovered W. W. Lane's 3" iron pipe with brass cap stamped: 1/4 38 basine iron pipe. 40 pins were visible.

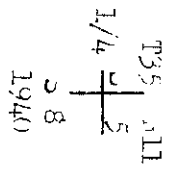

Description of monument and accessories I established to perpetuate the original location of this corner.

As Lane's iron pipe was recovered in very good condition, it was left in place.

1859 - White spruce 10" x 10" 34.6 links, scribed 1/4 SF.  
White spruce 12" x 8" ± 67 links, scribed 1/4 SF.  
Pile 5" x 8" x 46.8 links, scribed 1/4 SF.

Dated at Oneida, Wis., this 1st day of December, 1976

Signature Phillip T. Hansen Title Registered Land Surveyor Registration No. 498  
(County Surveyor, Registered Land Surveyor, or other duly authorized official)

Office of Register of Deeds, County of Oneida. I hereby certify that the within instrument was filed in this office for record on the 9th day of December, 1976 at 2:00 o'clock P. M.

Louis George Kuehn  
(Register of Deeds)

By Joseph M. Berman Deputy

3511050020