

CERTIFIED LAND CORNER RESTORATION



Index No. **B-9**

State of Wisconsin



Resident witnesses:

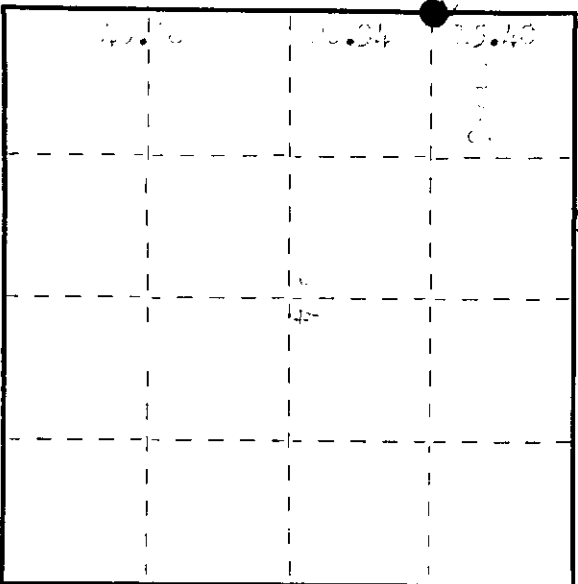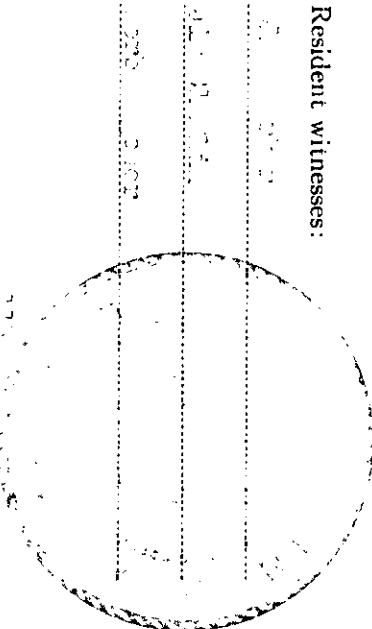

O = Corner monument restored.

History of original corner establishment:




Description of corner evidence found:

Recovered monument is a ... set ...

Description of monument and accessories I established to perpetuate the original location of this corner.

... established a new monument and accessories as described hereon to perpetuate the original location of this corner.






3511053000