

CERTIFIED LAND CORNER RESTORATION



Index No. E-2

State of Wisconsin

County of Oneida } ss.

I Phillip T. Hansen, do hereby certify that on the 31st day of July, 1979, I ~~restored~~ established the W. 1/16 corner of Sections 6 and 7 Township 35, North, Range 11 East, Fourth Principal Meridian, as described hereon, and that from this evidence I established a new monument and accessories as described hereon to perpetuate the original location of this corner.

Resident witnesses:
Glen Barker
Jim Clafflin
Herb Wagoner

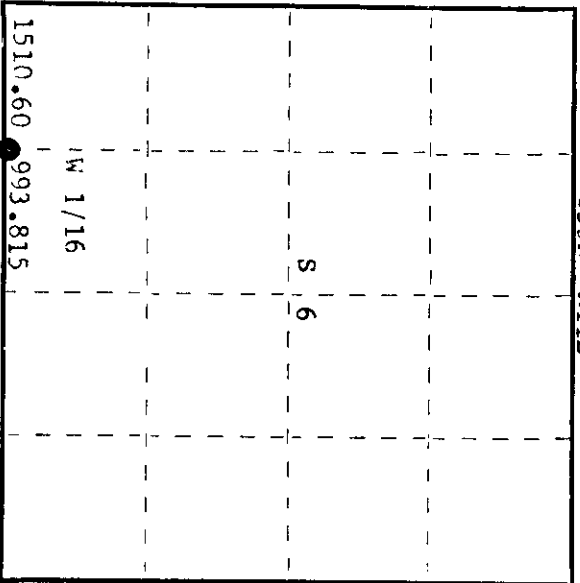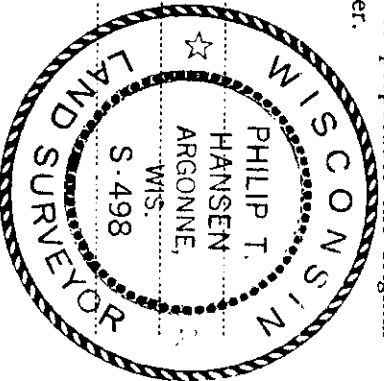

○ = Corner monument restored.

History of original corner establishment:

Corner established by H.C. Lawrence, Registered Land Surveyor, in 1953. Ran a random line S 83° E from section corners 1, 6, 7, 12 - 38.00 chains to recovered 1/4 corner between sections 6 and 7. Set the W 1/16 by proportionate measurement at 15.08 chains west of 1/4 corner. Set a 4" squared cedar post for W 1/16. Marked NBT's - Maple 5" N27°E 37 links and Tamarack 5" S45°E 46 links. As we subdivided the section 6, we traversed around it and established a new W 1/16.

Description of corner evidence found:

Ran traverse from 1/4 corner between sections 6 and 7 to section corner 1, 6, 7, 12. Computed distance is 2504.415 feet at bearing N 81° 05' 08" W. Location of W 1/16 computed by proportional distance to the original distance. W 1/16 computed at 1510.60 feet from section corners 6, 7, 12 and 993.815 from 1/4 corner. From this computed location H.C. Lawrence's corner bears N6°E 6.60 feet.

Description of monument and accessories I established to perpetuate the original location of this corner.

Set a 1-1/2" iron pipe with 2" brass cap, projecting 18", stamped:
 Marked NBT's -
 Maple 8" N81°W 22.17 feet S498
 Maple 10" S52°W 31.83 feet T35N R11E
 both scribed 1/16 RT. W 1/16 S+6
 CPI-1979

Dated at Rhinelander, Wis., this 7th day of August, 1979

Signature Phillip T. Hansen Title Registered Land Surveyor Registration No. S-498
 (County Surveyor, Registered Land Surveyor, or other duly authorized official)

Office of Register of Deeds, County of Oneida. I hereby certify that the within instrument was filed in this office for record on the 27th day of August, 1979 at 100 o'clock M.

Doris Francis Kurler
 (Register of Deeds)

By: _____ Deputy

3511060030