

CERTIFIED LAND CORNER RESTORATION

Index No. D-3


State of Wisconsin

County of Oneida } ss.

History of original corner establishment:
No records of any previous survey.

I Phillip T. Hansen, do hereby certify that on the 18th day of April, 1979, I found established ~~corner~~ of the SC 1/16 corner of Section 6, Township 35, North, Range 11 East, Fourth Principal Meridian, as described hereon; and that from this evidence I established a new monument and accessories as described hereon to perpetuate the original location of this corner.


Resident witnesses:
Glen Barker
Jim Clafflin
Herb Wagoner

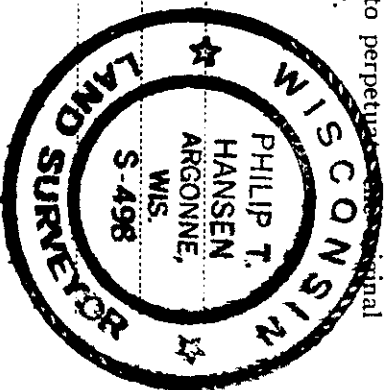

Description of corner evidence found:

No evidence of any corner recovered.
Corner established by traverse and computation. Computed distance from S 1/4 corner to C 1/4 corner is 2829.15 feet at bearing N 2° 56' 34" E. Set SC 1/16 at 1414.575 feet intermediate.

Description of monument and accessories I established to perpetuate the original location of this corner.
Set 1 1/2" iron pipe with 2" brass cap, projecting 18", stamped:
Placed rock cairn around base of monument.
Marked NBT's -
Maple 7" N25°W 5.98 feet, scribed 1/16 BT. S498
Oak 8" S70°W 30.0 feet, scribed 1/16 BT. T35N R11E
SC 1/16 S 16
CPI-1979

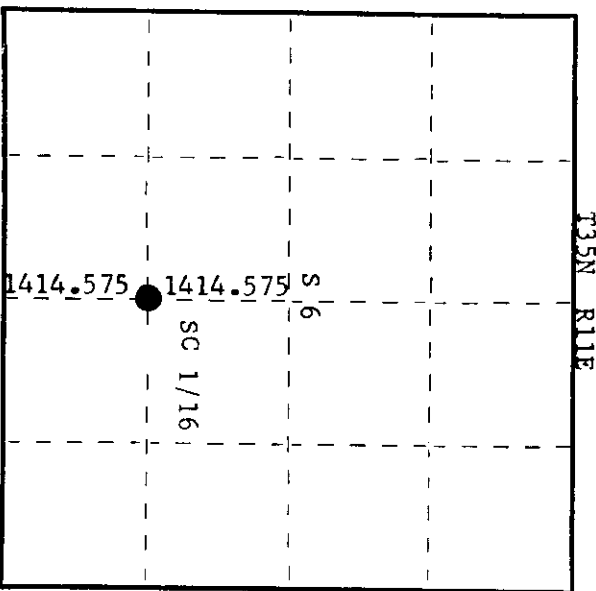

○ = Corner monument restored.

Dated at Rhineland, Wis., this 30th day of April, 1979.

Signature Phillip T. Hansen Title Registered Land Surveyor Registration No. S-498
(County Surveyor, Registered Land Surveyor, or other duly authorized official)
Office of Register of Deeds, County of Oneida
Instrument was filed in this office for record on the 14th day of May, 1979
at 1:30 o'clock P. M. I hereby certify that the within

Louis George Kuehn
(Register of Deeds)

By _____ Deputy

3511061020