CERTIFIED LAND CORNER RESTORATION

Index No. C-5

State of Wisconsin
County of [illegible] } ss.

I [illegible], do hereby certify that on the [illegible] day of [illegible], 19[illegible], I found evidence of the [illegible] corner of [illegible] Township 35, North, Range [illegible], Fourth Principal Meridian, as described hereon; and that from this evidence I established a new monument and accessories as described hereon to perpetuate the original location of this corner.

Resident witnesses:

[illegible]

[illegible]

[illegible]

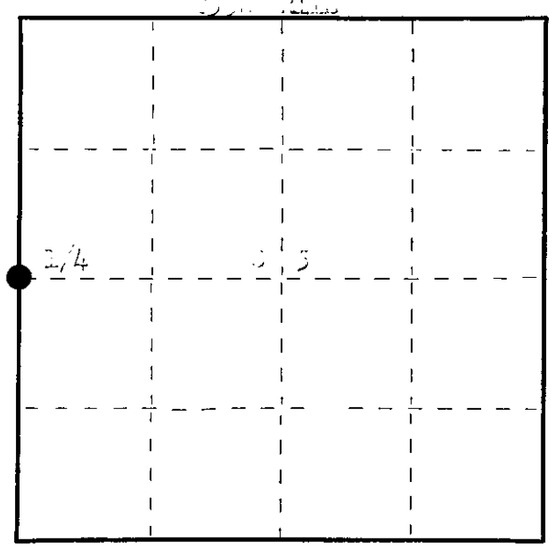

○ = Corner monument restored.

FORM 985

History of original corner establishment:

[illegible] 55 links [illegible] 105 links.

[illegible], registered land surveyor, recovered the corner while cruising. [illegible] 3" oak post [illegible] 3, links. [illegible] tied into [illegible] 1/16 corners.

Description of corner evidence found:

Recovered [illegible] 2" iron pipe with brass cap, [illegible] [illegible] rock [illegible] base of pipe.

[illegible] 1/4 [illegible], [illegible]

[illegible] 1940

[illegible] 37 links (37.4 links), [illegible].

Description of monument and accessories I established to perpetuate the original location of this corner.

[illegible] monument was in perfect condition, it was left in place.

[illegible] 2" above ground.

[illegible] 37 - [illegible] links, [illegible] 1/4 [illegible].

Dated at Minocqua, Wis., this 30th day of November, 19 76.

Signature [illegible] Title Registered Land Surveyor Registration No. 2478
(County Surveyor, Registered Land Surveyor, or other duly authorized official)

Office of Register of Deeds, County of Oneida, I hereby certify that the within instrument was filed in this office for record on the 9th day of December, 19 76 at 2:02 o'clock P. M.

Doris Verage Kuehn
(Register of Deeds)

By Joseph M. Boomer Deputy

351106 2000