

CERTIFIED LAND CORNER RESTORATION

Index No. C-4

State of Wisconsin

County of Oneida } ss.

History of original corner establishment:  
No records of any previous surveys.

I Phillip T. Hansen, do hereby certify that on the 19th day of April 19 79, I ~~restored~~ ~~relocated~~ ~~of the~~ corner of the EC 1/16 Section 6

Township 35 North, Range 11 East, Fourth Principal Meridian,


as described hereon; and that from this evidence I established a new monument and accessories as described hereon to perpetuate the original location of this corner.

Resident witnesses:


Glen Barker

Jim Clafflin

Herb Wagoner

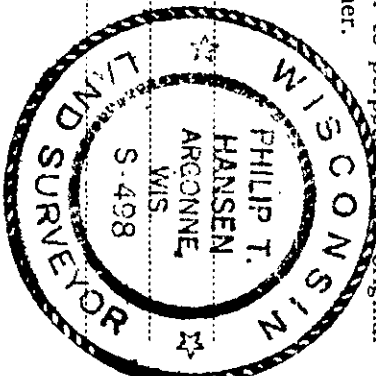

T35N R11E

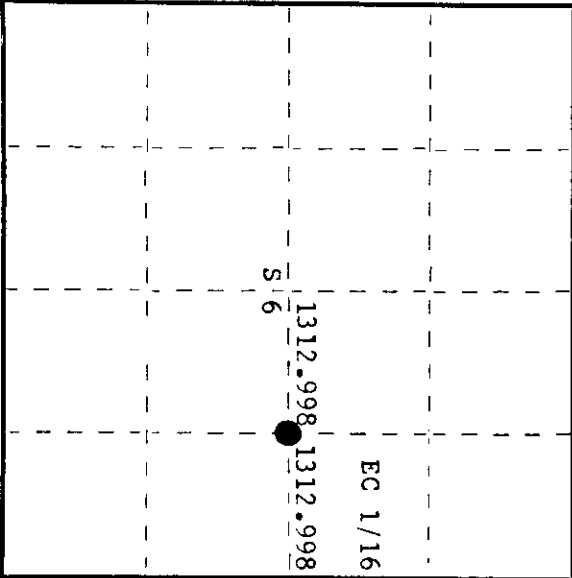

○ = Corner monument restored.

Description of corner evidence found:  
No evidence of any corner recovered. Corner established by traverse and computation. The computed distance from established C 1/4 corner to E 1/4 corner is 2635.997 feet at bearing S 85° 35' 34" E. Set EC 1/16 at 1312.998 feet intermediate.

Description of monument and accessories I established to perpetuate the original location of this corner.  
Set a 1-1/2" iron pipe with 2" brass cap, projecting 18", stamped:  
Marked NBT's -

Black Spruce 7" S77°E 9.08 feet S498  
Maple 7" N63°W 18.70 feet T35N R11E  
both scribed 1/16 BT. EC 1/16 S 6  
CPI-1979

Dated at Rhinelander, Wis., this 30th day of April, 19 79

Signature: Phillip T. Hansen, Title: Registered Land Surveyor, Registration No. S-498  
(County Surveyor, Registered Land Surveyor, or other duly authorized official)

Office of Register of Deeds, County of Oneida  
Instrument was filed in this office for record on the 21st day of May, 19 79  
at 2:00 o'clock P.M.

Doreen Verge Kuehn  
(Register of Deeds)

By: Deputy

3511062010