

CERTIFIED LAND CORNER RESTORATION



Index No. C-3

State of Wisconsin } ss.
County of Oneida

History of original corner establishment:
No records of any previous survey.

I, Philip T. Hansen, do hereby
certify that on the 18th day
of April, 1979, I ~~found~~
~~restored~~ restored the C 1/4
corner of Section 6
Township 35, North, Range
11, East, Fourth Principal Meridian,
as described hereon; and that from this evidence
I established a new monument and accessories
as described hereon to perpetuate the original
location of this corner.

Resident witnesses:
Glen Barker
Jim Claflin
Herb Wagoner

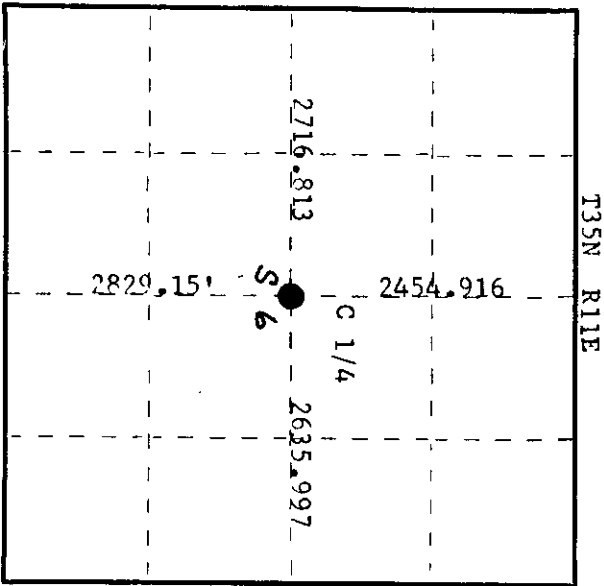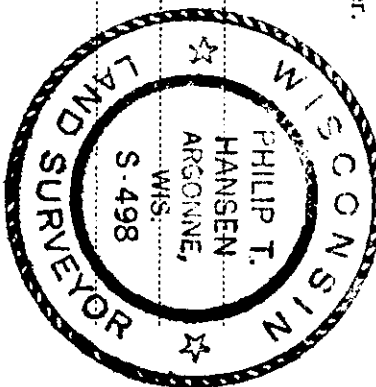

○ = Corner monument restored.

Description of corner evidence found:
No evidence of any corner recovered.
Corner established by traverse and computation. Ran the N-S 1/4 line and the E-W 1/4 line to establish C 1/4 corner. Corner set S 2° 56' 34" W 2454.916 feet from N 1/4 corner, N 85° 35' 34" W, 2625.997 feet from E 1/4 corner N 2° 56' 34" E 2829.15 feet from S 1/4 and S 85° 35' 34" E 2716.813 feet from W 1/4 corner.

Description of monument and accessories I established to perpetuate the original location of this corner.
Drove a 1 1/2" x 18" iron rod, flush with the ground 8.0 ft. east of the centerline of the Chicago Northwestern N-S railroad tracks.
Set a 2 1/2" Bernsten A-1 Federal Monument 35 feet east of true corner. Monument projects 12", cap stamped:
Marked B.O. - Power Pole #35-11 6W3 N62°W 58.99 feet
telephone pole N5°E 38.88'
measurements made to monument
T35N R11E
C 1/4 C + S W.C.
W 35 ft.
S498 - 1979

Dated at Rhineclander, Wis., this 30th day of April, 1979.

Signature Philip T. Hansen Title Registered Land Surveyor Registration No. S-498
(County Surveyor, Registered Land Surveyor, or other duly authorized official)

Office of Register of Deeds, County of Oneida, I hereby certify that the within
instrument was filed in this office for record on the 14th day of May, 1979
at 1:30 o'clock P. M.

Doris Verage Tucker
(Register of Deeds)

By _____ Deputy

3511062020

