

CERTIFIED LAND CORNER RESTORATION



Index No. B-4

State of Wisconsin } ss.  
County of Oneida

History of original corner establishment:  
No records of any previous survey.

I Philip T. Hansen, do hereby certify that on the 17th day of April, 1979, I found ~~existence of the~~ established corner of the NE 1/16 corner of Section 6, Township 35, North, Range 11, East, Fourth Principal Meridian, as described hereon; and that from this evidence I established a new monument and accessories as described hereon to perpetuate the original location of this corner.

Resident witnesses:  
Glen Barker  
Jim Clafin  
Herb Wagoner

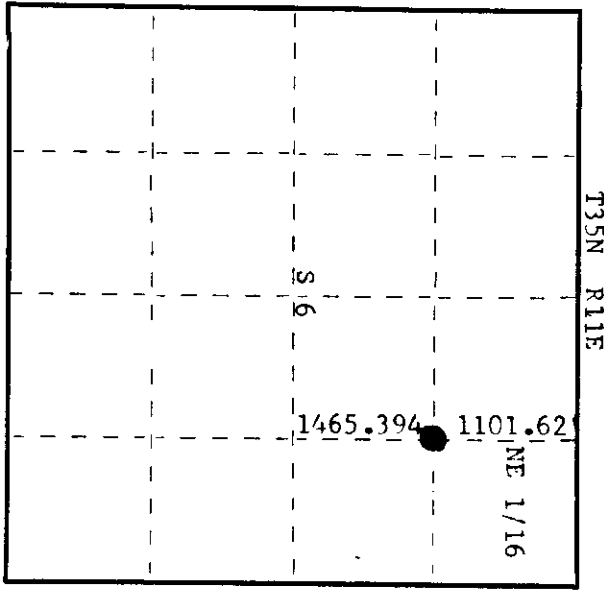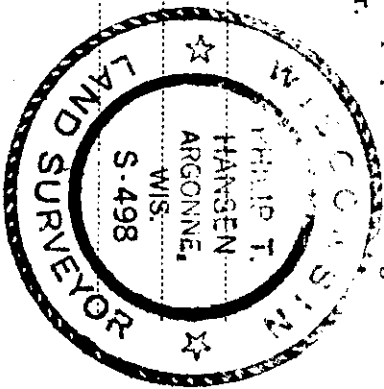

O = Corner monument restored.

Description of corner evidence found:

No evidence of any corner recovered.  
Corner established by traverse and computation. Computed line between E 1/16 between sections 6 and 31 and EC 1/16 is 2566.456 feet at bearing S 2° 48' 17" W.  
Computed location of NE 1/16 is S 2° 48' 17" W 1101.062 feet of E 1/16 and N 2° 48' 17" E 1465.394 feet of EC 1/16.

Description of monument and accessories I established to perpetuate the original location of this corner.  
Set 1 1/2" iron pipe with 2" brass cap projecting 18", stamped:  
Placed rock cairn around base of monument.

Marked NBT's -  
Maple 8" N19°W 10.73 feet S498  
Maple 5" N75°E 11.65 feet scribed 1/16 BT. NE 1/16 S+6  
CPI-1979

Dated at Rhineland, Wis., this 30th day of April, 1979

Signature Philip T. Hansen Title Registered Land Surveyor Registration No. S-498  
(County Surveyor, Registered Land Surveyor, or other duly authorized official)

Office of Register of Deeds, County of Oneida  
Instrument was filed in this office for record on the 14th day of May, 1979  
at 1:30 o'clock P. M.

Signature James Verage Kuehn  
(Register of Deeds)

By James Verage Kuehn Deputy

3511063010