

CERTIFIED LAND CORNER RESTORATION

Index No. B-3

State of Wisconsin

County of Oneida } ss.

History of original corner establishment:
No records of any previous survey.

I, Phillip T. Hansen, do hereby certify that on the 4th day of June, 1979, I ~~found~~ established the NC 1/16 corner of Section 6, Township 35, North, Range 11 East, Fourth Principal Meridian, as described hereon; and that from this evidence I established a new monument and accessories as described hereon to perpetuate the original location of this corner.

Description of corner evidence found:

No evidence of any corner recovered. Corner established by traverse and computation. Ran N-S and E-W 1/4 lines from previously recovered quarter corners to establish the C 1/4 corner. Computed distance from C 1/4 corner to N 1/4 corner is 2454.716 feet at bearing S 2° 56' 34" W.


Established the NC 1/4 corner at point S 2° 56' 34" W, 1025.636 feet from N 1/4 corner and 1429.080 feet N 2° 56' 34" E of C 1/4.

Resident witnesses:


Glen Barker

Jim Clafin

Herb Wagoner

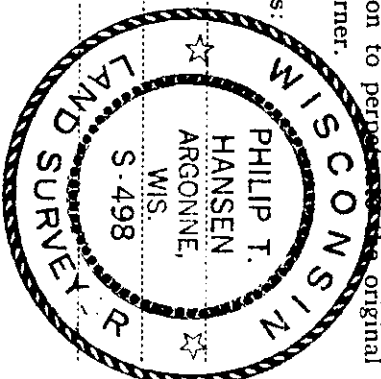

T35N R11E

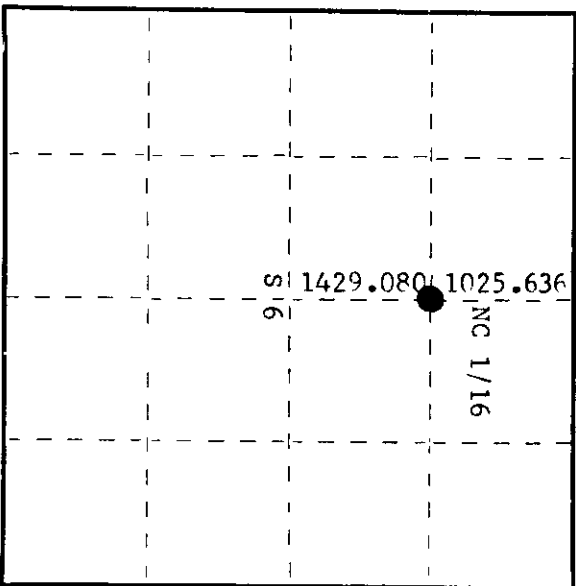

○ = Corner monument restored.

Description of monument and accessories I established to perpetuate the original location of this corner.
Set a 1-1/2" iron pipe with 2" brass cap projecting 24" - stamped:
Placed a rock cairn around base of monument.

Marked NBT's -

Maple 6" N85°W 4.45' scribed 1/16 BT.

Maple 5" S9°E 9.58' scribed 1/16 BT.

S498

T35N R11E

NC 1/16 S+6

CPI-1979

Dated at Rhinelander, Wis., this 12th day of June, 1979.

Signature: Phillip T. Hansen Title: Registered Land Surveyor Registration No. S-498
(County Surveyor, Registered Land Surveyor, or other duly authorized official)

Office of Register of Deeds, County of Oneida
Instrument was filed in this office for record on the 7th day of August, 1979 at 1:00 o'clock P. M. I hereby certify that the within

Doreen Long Kuehn
(Register of Deeds)

By: _____ Deputy