

CERTIFIED LAND CORNER RESTORATION


Index No. **72**

State of Wisconsin

County of Oneida } ss.

I Phillip T. Hansen do hereby certify that on the 22nd day of August, 1975, I found evidence of the W-1/16 corner of Sections 7 and 18 Township 35, North, Range 11 East, Fourth Principal Meridian, as described hereon; and that from this evidence I established a new monument and accessories as described hereon to perpetuate the original location of this corner.

Resident witnesses:
Glen Barker
Jin Claflin

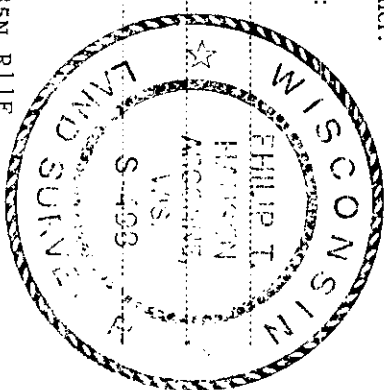

History of original corner establishment:
 Original corner set by H.C. Hall, County Surveyor. Corner recovered and restored by H.C. Lawrence, Registered Land Surveyor, in 1959. From recovered 1/4 corner, he ran a random line west, at 19.57 chains, He recovered Hall's 1/16 post 83 links south. Found old BT's down but marks intact. Set new 4" cedar post and marked NBT: Cedar stump 15" N55°E, 29 links, iron pipe and cedar stake marked the corner.


Description of corner evidence found:
 Recovered 3" cedar post, squared and scribed 1/8S S7, S18 in very poor condition. Also, a 4" cedar post, squared and scribed, scribing partly visible, lying beside other post and a 2" iron pipe driven in muck beside the post.

Recovered OBT: Cedar stump 15" N55°E 29 links-scribed W-1/16 S7, S18

Description of monument and accessories I established to perpetuate the original location of this corner.
 Replaced iron pipe and wood post with 1-1/2" OD Iron pipe w/2" brass cap stamped -

NBT's: Black ash 5" N18°W 35.5 links-scribed 1/16 BT
 Black ash 5" S40°W 7.5 links-scribed 1/16 BT

S498
 T35N R11E
 W-1/16 S|7
 S|18
 CPT-1975

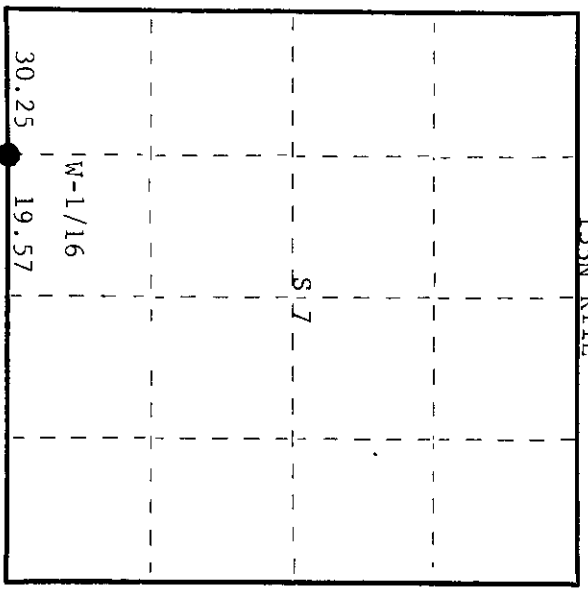

○ = Corner monument restored.

Dated at Rhinelander, Wis., this 12th day of September, 1975.

Signature Phillip T. Hansen Title Registered Land Surveyor Registration No. S-498
 (County Surveyor, Registered Land Surveyor, or other duly authorized official)

Office of Register of Deeds, County of Oneida
 Instrument was filed in this office for record on the 17th day of November 1975
 at 10:00 o'clock A. M.

Doree Savage Fuchs
 (Register of Deeds)

By: _____ Deputy

35/1070030