CERTIFIED LAND CORNER RESTORATION

Index No. H-5

State of Wisconsin
County of Oneida } ss.

I Philip T. Hansen, do hereby certify that on the 19th day of May, 19 75, I found evidence of the S-1/16 corner of Sections 7 and 8 Township 35, North, Range 11 East, Fourth Principal Meridian, as described hereon; and that from this evidence I established a new monument and accessories as described hereon to perpetuate the original location of this corner.

Resident witnesses:

WISCONSIN PHILIP T. HANSEN ARGONNE, WIS. S-498 LAND SURVEYOR

T35N, R11E

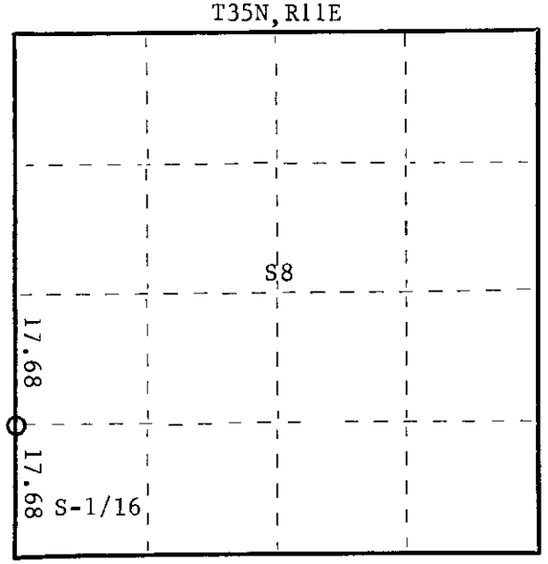

○ = Corner monument restored.

History of original corner establishment:

Original corner established by D.H. Vaughan, County Surveyor, in 1916.

Corner recovered by H.C. Lawrence, Registered Land Surveyor, in 1946 during his retracement survey.

Lawrence set a new 4" hemlock post at Vaughan's S-1/16 corner, established NBT's.
Hemlock 14" bears N88°E 25½ links
Hemlock 12" bears S27°W 31 links

Description of corner evidence found:
Recovered H.C. Lawrence's 4" hemlock post, squared and scribed S-1/16 S7, S-1/16 S8 in good condition. Also found a decayed 2" x 4" x 2' cedar stake lying beside it.

Recovered OBT's -	Hemlock 14"(15)	N88°E	25.5 links	scribed S8 BT
	Hemlock 12"	S27°W(S24°W)	31 links	scribed S7 BT

Description of monument and accessories I established to perpetuate the original location of this corner.
Replaced hemlock post with 1½ O.D. iron pipe with 2" brass cap stamped - S498 T35N, R11E

No new BT's established.

S-1/16 S7|S8

CPI-1975

Dated at Rhinelander, Wis., this 4th day of June, 19 75

Signature Philip T. Hansen Title Registered Land Surveyor Registration No. S-498
(County Surveyor, Registered Land Surveyor, or other duly authorized official)

Office of Register of Deeds, County of Oneida, I hereby certify that the within instrument was filed in this office for record on the 1st day of October, 19 75 at 3:00 o'clock P. M.

Doris Verage Kuehn
(Register of Deeds)

By ..... Deputy

FORM 985 H. C. MILLER CO., MILWAUKEE

35110710 00