

CERTIFIED LAND CORNER RESTORATION


Index No. **Q.5**

State of Wisconsin

County of Oneida } ss.

I, Philip T. Hansen, do hereby certify that on the 19th day of May, 1975, I found evidence of the 1/4 corner of Sections 7 and 8 Township 35 North, Range 11 E, Fourth Principal Meridian, as described hereon; and that from this evidence I established a new monument and accessories as described hereon to perpetuate the original location of this corner.

Resident witnesses:

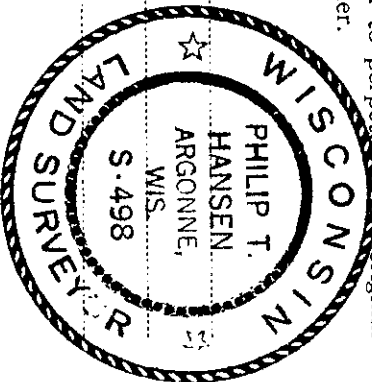

History of original corner establishment:
Original corner established by Wm. E. Dougherty, Govt. Deputy Surveyor, in 1859 from which he made BT, tamarack 8" bears N49°W, 10 links and cedar 8" bears S33°E, 12 links. H.C. Lawrence, Registered Land Surveyor, recovered an iron pipe (origin unknown) during his retracement survey in 1946. He set a new 4" cedar post from which yellow birch 9" bears S51°W, 49 links and elm 10" bears N37°E, 72 links. V.M. Maine, County Surveyor, set an iron pipe w/brass cap at this location.

Description of corner evidence found:

Recovered 4" cedar post, squared and scribed 1/4S S7, 1/4S S8 in good condition.
Recovered 2-1/2" iron pipe set by Maine, with old 4" cedar post, scribed one side tied to it. Brass cap stamped -


T35 R11

Recovered OBT's: Yellow birch 9" (11) S51°W(S55°W) 49 links scribed 1/4BT
Elm 10" (12) N37°E(N42°E) 72 links

1940 M

Description of monument and accessories I established to perpetuate the original location of this corner.
As iron pipe and wooden post were straight and in good condition, they were left in place.

No new BT's established.

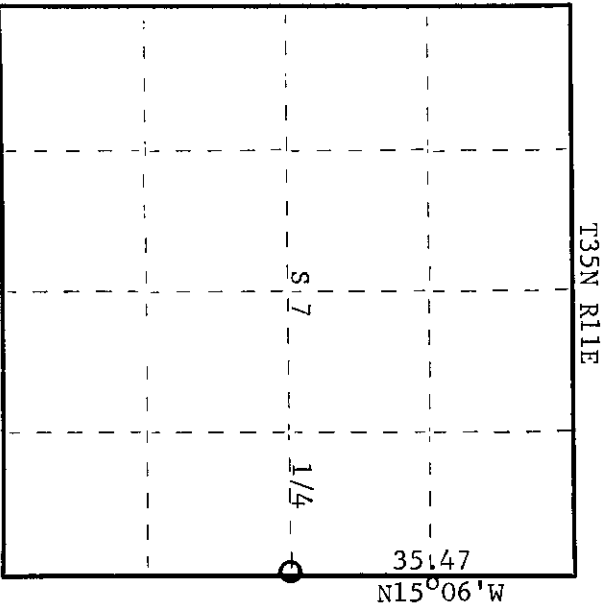

O = Corner monument restored.

Dated at Rhinelander, Wis., this 6th day of June, 1975.

Signature: *Philip T. Hansen* Title: Registered Land Surveyor Registration No. S-498
(County Surveyor, Registered Land Surveyor, or other duly authorized official)

Office of Register of Deeds, County of Oneida. I hereby certify that the within instrument was filed in this office for record on the 1st day of October, 1975 at 3:00 o'clock P.M.

By: *Doree Verge* (Register of Deeds)

By: Deputy

00020000