

CERTIFIED LAND CORNER RESTORATION

Index No. **G-4**

State of Wisconsin } ss.

County of Oneida

I Phillip T. Hansen, do hereby



certify that on the 30th day of June, 1975, I found

evidence of the EC-1/16 corner of the Section 7

Township 35, North, Range 11 East, Fourth Principal Meridian,

as described hereon; and that from this evidence I established a new monument and accessories as described hereon to perpetuate the original location of this corner.

Resident witnesses:

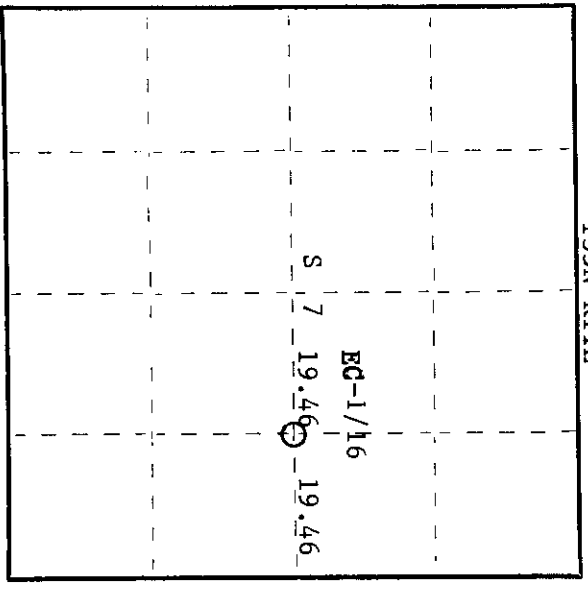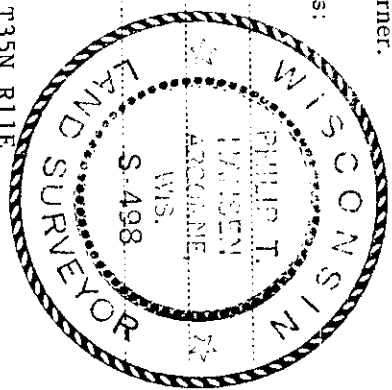

O = Corner monument restored.

History of original corner establishment:

Corner established by H.C. Lawrence, Reg. Land Surveyor, during his retracement and subdivision survey during 1959. Set EC-1/16 corner equidistant (19.46 chains) between established C-1/4 corner and E-1/4, Section 7, from which black cherry 6" bears S25°W 26 links and white birch 7" bears N80°E 18½ links.

Description of corner evidence found:

This corner had been destroyed because of clearing along the Public Service highway right-of-way. The white birch 7" N80°E 18.5 links was also destroyed.

Recovered black cherry 6" S25°W 26 links scribed EC-1/16 BT.

Description of monument and accessories I established to perpetuate the original location of this corner.

Set a 1-1/2" O.D. iron pipe with 2" brass cap at N25°E 26 links from 6" black cherry BT. Brass cap stamped -

NBT - white birch 6" N30°W 37.5 links scribed 1/16 BT.

S498
T35N R11E
EC-1/16 S 7
CPI 1975

Dated at Rhinelander, Wis., this 17th day of July, 1975.

Signature *Phillip T. Hansen* Title Registered Land Surveyor Registration No. S-498
(County Surveyor, Registered Land Surveyor, or other duly authorized official)

Office of Register of Deeds, County of Oneida, I do hereby certify that the within instrument was filed in this office for record on the 1st day of October, 1975, at 3:00 o'clock P.M.

Jane Berge Kuehn
(Register of Deeds)

By: Deputy

3511072010