


CERTIFIED LAND CORNER RESTORATION

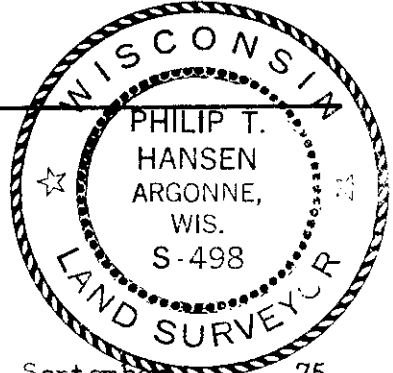

State of Wisconsin }
 County of Oneida } ss.

I Philip T. Hansen do hereby certify that on the 3rd day of September 1975, I found evidence of the $C\frac{1}{4}$ corner of Section 7, Township 35 North, Range 11 East, Fourth Principal Meridian, as described hereon; and that from this evidence I established a new monument and accessories as described hereon to perpetuate the original location of this corner:

Description of original monument and accessories and subsequent restorations: Corner established by H. C. Lawrence, Registered Land Surveyor in 1946. Established $C\frac{1}{4}$ from intersection of corrected N-S and E-W quarter lines. Set new cedar post, but no BTs. Corner is 38.92 chains west of $E\frac{1}{4}$ corner, 38.59 chains south of $N\frac{1}{4}$ corner, 44.64 chains east of $W\frac{1}{4}$ cor. and 37.87 chains north of $S\frac{1}{4}$ corner.

Description of corner evidence found:


Recovered 3" cedar post, squared and scribed $C\frac{1}{4}$ S 7. $C\frac{1}{4}$ in poor condition
 No BTs were in evidence.

Description of monument and accessories I established to perpetuate the location of this corner:

Replaced 3" cedar post with 2 1/2" iron pipe w/brass cap stamped.

NBT Black Ash 10" N 61° E scribed $\frac{1}{4}$ BT 26 lks
 Cedar 6" S 17° W 58.4 lks scribed $\frac{1}{4}$ BT

S 498
 T 35 N R 11 E
 S 7
 $C\frac{1}{4}$
 CPI 1975

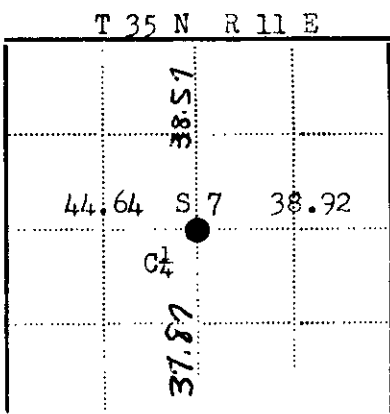

● - Corner monument restored
 □ -

Resident witnesses Glen Barker and Jim Ulfelin

Dated at Rhineland Wisconsin, this 16 day of September 1975.

Signature Philip T. Hansen Title Reg. Land Surveyor
 (County Surveyor, Registered Land Surveyor, or other duly authorized official)

Surveyors Registration No. S 498

Office of Register of Deeds County of Oneida

I hereby certify that the within instrument was filed in this office for record on the 14th day of October 1975, and was filed in Book No. 1 Page No. of County Records.

Signature Doris Verage Kuehn Title Register of Deeds

Township 35 North Range 11 East Section 7, Index No. Page No.