

CERTIFIED LAND CORNER RESTORATION

Index No. **59**

State of Wisconsin



County of Oneida } ss.

I Philip T. Hansen, do hereby certify that on the 16th day of May, 1975, I found

evidence of the Section corner of Sections 8, 9, 16, and 17 Township 35, North, Range 11 East, Fourth Principal Meridian,

as described hereon; and that from this evidence I established a new monument and accessories as described hereon to perpetuate the original location of this corner.

Resident witnesses:

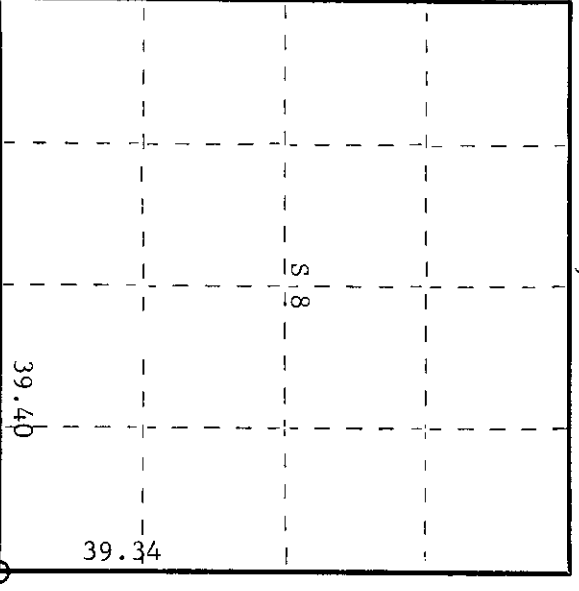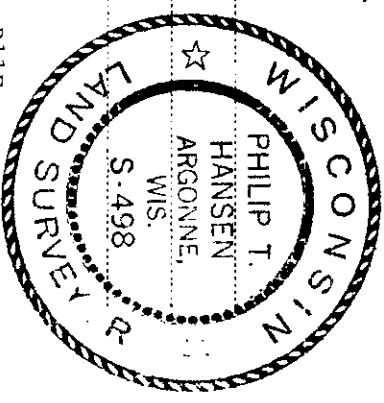

○ = Corner monument restored.

History of original corner establishment:

Original corner established by Wm. E. Dougherty, Gov. Deputy Surveyor, in 1859, from which white pine 10" bears S27°W, 20 links and white birch 9" bears N55°E, 10 links. Corner restored by D.H. Vaughan, County Surveyor, in 1916. Set new post and made new BT white pine 18" N58°W, 6-1/2 links.

Corner restored in 1954 by H.C. Lawrence, Registered Land Surveyor. He recovered original BT white pine stump S25°W, 20 links. Vaughan's white pine 18" N58°W, 6-1/2 links. Set new cedar post and made NBT's yellow birch 18" S56-1/2°E, 26 links and maple 8" S41°W, 37 links.

Description of corner evidence found:
Recovered H.C. Lawrence's 5" cedar post, squared and scribed S8, S17, S16, S9, in good condition. Also 1-1/2" iron pipe set up beside it.

Recovered OBT - White pine stump	18"	N58°W	6.5 links	scribed S8 BT
Yellow birch	18"	S56-1/2°E	26 links	scribed S16 NBT
Red maple	9"	S41°W	37 links	scribed S17 NBT

Description of monument and accessories I established to perpetuate the original location of this corner.

Replaced 5" wooden post with 2-1/2" aluminum pipe with cast aluminum cap stamped -

No new BT's established.

Sec. S8 | S9
S17 | S16
CPT-1975

Dated at Rhineland, Wis., this 4th day of June, 1975.

Signature Philip T. Hansen Title Registered Land Surveyor Registration No. S-498
(County Surveyor, Registered Land Surveyor, or other duly authorized official)

Office of Register of Deeds, County of Oneida, I hereby certify that the within instrument was filed in this office for record on the 16th day of October, 1975 at 3:00 o'clock P. M.

Doris Leage Kuehn
(Register of Deeds)

By: _____ Deputy

3511080000