

CERTIFIED LAND CORNER RESTORATION



Index No. **5-8**

State of Wisconsin } ss.

County of Oneida

I Philip T. Hansen, do hereby certify that on the 15th day of May, 1975, I found evidence of the E-1/16 corner of Sections 8 and 17 Township 35, North, Range 11 East, Fourth Principal Meridian, as described hereon; and that from this evidence I established a new monument and accessories as described hereon to perpetuate the original location of this corner.

Resident witnesses:

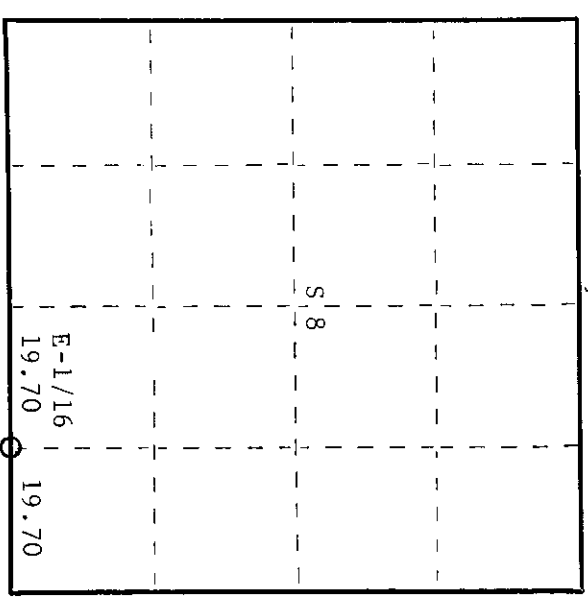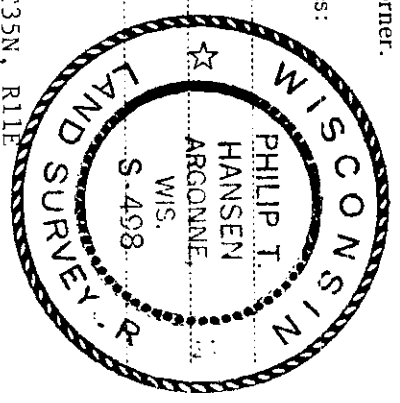

○ = Corner monument restored.

History of original corner establishment:

Corner established by H.C. Lawrence, Registered Land Surveyor, in 1954 during his retracement survey.

He ran a random line S89°30'E from S-1/4 corner between Sections 7 and 18 a distance of 39.40 chains to intersect his line between Sections 16 and 17 at a point 330 links south of Section Corner. Corrected line and bearing to N85°43'E. Set E-1/16 corner 1.65 chains north at right angles at 19.70 chains equidistant.

Description of corner evidence found:

Recovered 5" cedar post, squared and scribed E-1/16 S8; E-1/16 S17 in good condition. Also found a 1-1/2" iron pipe beside it.

No BT's recovered.

Description of monument and accessories I established to perpetuate the original location of this corner.

Replaced 5" cedar post with 1-1/2" O.D. iron pipe with 2" brass cap stamped -

Established NBT's -	White birch	6"	S43°W	23 links	scribed 1/16 BT	E-1/16 S18
	White birch	5"	N66°E	28 links	scribed 1/16 BT	S117

S498
T35N, R11E
CPI-1975

Dated at Rhineland, Wis., this 4th day of June, 1975

Signature: Philip T. Hansen Title: Registered Land Surveyor Registration No. S-498
(County Surveyor, Registered Land Surveyor, or other duly authorized official)

Office of Register of Deeds, County of Oneida
Instrument was filed in this office for record on the 1st day of October, 1975
at 3:00 o'clock P. M.

Doris Verge Tuck
(Register of Deeds)

By: _____ Deputy

3511080010