

CERTIFIED LAND CORNER RESTORATION



Index No. **G-9**

State of Wisconsin

County of Oneida } ss.

I Phillip T. Hansen, do hereby certify that on the 6th day of June, 1975, I found evidence of the 1/4 corner of Section 8 and 9 Township 35, North, Range 11 E, Fourth Principal Meridian, as described hereon; and that from this evidence I established a new monument and accessories as described hereon to perpetuate the original location of this corner.

Resident witnesses:

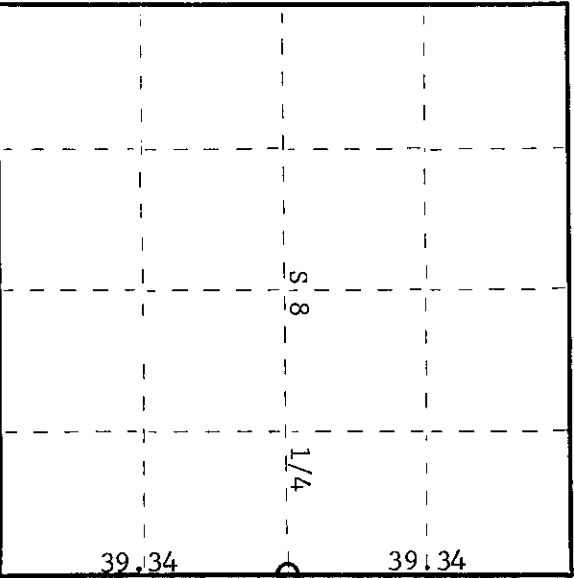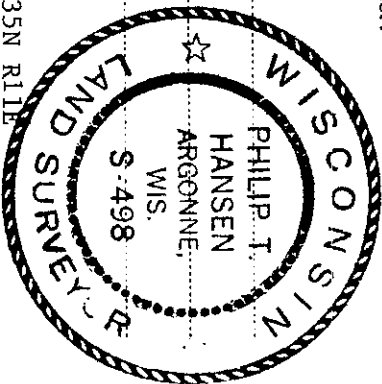

○ = Corner monument restored.

History of original corner establishment:

Original corner established by Wm. E. Dougherty, Govt. Deputy Surveyor, in 1859. Spruce 10" bears S69°W, 8 links and spruce 7" bears N20°E, 4 links. B.F. Dorr claims to have recovered the original bearing trees and reset this 1/4 corner. Corner recovered by H.C. Lawrence, Registered Land Surveyor, in 1954. He states he found the spruce tree used by Dorr as BT down, marks okay, bears S62-1/2W, 8 links. Recovered point of original post and the point of another post. He set a new post 5" cedar from which cedar 12" bears S48°W, 49 links and cedar 14" bears S75°E, 36 links.

Description of corner evidence found:

Recovered 5" cedar post, squared and scribed S8-1/4S, S9-1/4S in fair condition.
 Recovered OBT's: Cedar 12" (13) S48°W 49 links scribed 1/4 S8 NBT
 Cedar 14" (16) S75°E 36 links scribed 1/4 S9 BT

Description of monument and accessories I established to perpetuate the original location of this corner.

Replaced wooden stake with 2-1/2" iron pipe w/brass cap stamped -

No new BT's established.

S498
T35N R11E

S8 | S9
1/4
CPI-1975

Dated at Rhineland Wis. this 6th day of June, 1975.

Signature Phillip T. Hansen Title Registered Land Surveyor Registration No. S-498
 (County Surveyor, Registered Land Surveyor, or other duly authorized official)

Office of Register of Deeds, County of Oneida I hereby certify that the within instrument was filed in this office for record on the 1st day of October, 1975 at 3:00 o'clock P. M.

Debra Strange Fisher
 (Register of Deeds)

By: _____ Deputy

3511082000