

CERTIFIED LAND CORNER RESTORATION



Index No. **G-7**

State of Wisconsin

County of Oneida } ss.

I, Phillip T. Hansen, do hereby certify that on the 21st day of May, 1975, I found evidence of the C-1/4 corner of the Section 8 Township 35 North, Range 11 E, Fourth Principal Meridian, as described hereon; and that from this evidence I established a new monument and accessories as described hereon to perpetuate the original location of this corner.

Resident witnesses:

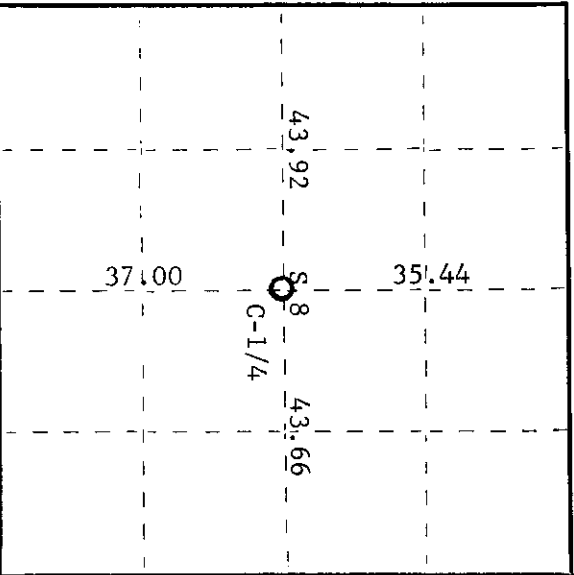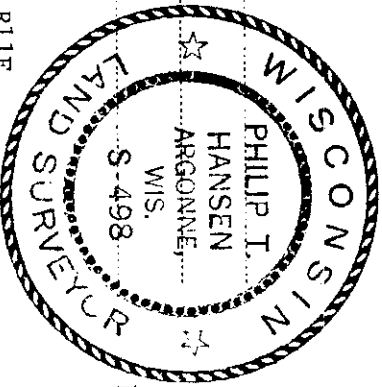

○ = Corner monument restored.

History of original corner establishment:

Original corner established by D.H. Vaughan, County Surveyor, in 1916. Set post and hemlock BI due north at 1.72 chains. Corner recovered by H.C. Lawrence, Registered Land Surveyor, in 1954 during his retracement survey. States he recovered Vaughan's C-1/4 corner while running the East-West-1/4 line. Found Vaughan's post and hemlock stub due north at 1.72 chains. Set new 5" tamarack post from which NBT, tamarack 6", bears S79°E, 104-1/2 links.

Description of corner evidence found:

Recovered Lawrence's 5" tamarack post, squared and scribed C-1/4S S8, C-1/4S S8 in good condition. Also a 5" cedar post, squared and scribed but badly decayed. Scribing not readable, lying on ground. No record of OBT's in field, so was unable to locate any.

Description of monument and accessories I established to perpetuate the original location of this corner.

Replaced 5" tamarack post with 2-1/2" aluminum post w/brass cap, magnet in cap and anchor, stamped -

Established NBT: Black spruce 8" N77°E 88 links
White birch 5" S40°E 85 links scribed 1/4BT

S498
T35N R11E
C-1/4 S/8
CPI-1975

Dated at Rhineland, Wis., this 9th day of May, 1975.

Signature Phillip T. Hansen Title Registered Land Surveyor Registration No. S-498
(County Surveyor, Registered Land Surveyor, or other duly authorized official)

Office of Register of Deeds, County of Oneida I hereby certify that the within instrument was filed in this office for record on the 1st day of October, 1975 at 3:00 o'clock P. M.

Lois Lorange Kuehn
(Register of Deeds)

By: _____ Deputy

3511082020