

CERTIFIED LAND CORNER RESTORATION

Index No. F-6

State of Wisconsin

County of Oneida } ss.



I, Phillip T. Hansen, do hereby certify that on the 10th day of November 1976, I found evidence of the N 1/16 corner of Section 5 Township 35, North, Range 11 East, Fourth Principal Meridian, as described hereon; and that from this evidence I established a new monument and accessories as described hereon to perpetuate the original location of this corner.

Resident witnesses:

Glen Barber

Jim Martin

Herb Hanson

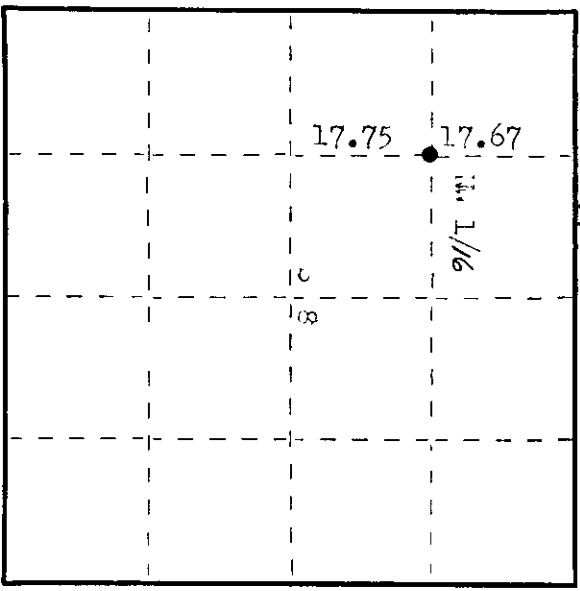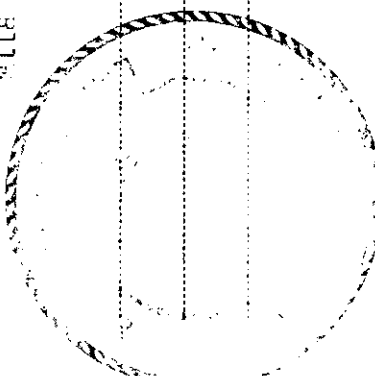

○ = Corner monument restored.

History of original corner establishment:

Corner established by W. F. Aime. H. C. Lawrence, Registered Land Surveyor, recovered this corner, ran north and south from it to test its position. at 17.75 chains closed out 34 links west of N 1/16 and north, closed out 34 links east of N 1/16 at 17.67 chains. set new cedar post and marked white Birch 7" @ 30° = 16 links, white Birch 7" @ 55° = 27 links.

Description of corner evidence found:

Recovered Lawrence's 4" cedar post, squared and scribed N 1/16 as in poor condition. Also an old 3" squared cedar post lying beside it.

Recovered old - white Birch 7" (or) @ 30° = 16 links; scribed as of. white Birch 7" (or) @ 55° = 27 links; scribed N 1/16 as of.

Description of monument and accessories I established to perpetuate the original location of this corner.

Replaced cedar post with 1 1/2" OD iron pipe with brass cap stamped: monument projects 2' above ground. T35N R11E
T35N - Sugar 8" @ 58° = 35.8 links; scribed 1/16 as of. 498
Nov 1/16 1976
JPH-1976

Dated at Oneida, Wis., this 1st day of December, 1975

Signature Phillip T. Hansen Title Registered Land Surveyor Registration No. 3-493
(County Surveyor, Registered Land Surveyor, or other duly authorized official)

Office of Register of Deeds, County of Oneida. I hereby certify that the within instrument was filed in this office for record on the 9th day of December, 1976 at 2:00 o'clock P. M.

Dana Savage Thiel
(Register of Deeds)

By Joseph M. Brown Deputy

351108 3030