

CERTIFIED LAND CORNER RESTORATION

Index No. J-13

State of Wisconsin

County of Oneida

} ss.


I Phillip T. Hansen, do hereby certify that on the 11th day of January, 1978, I found evidence of the Section corner of Sec. 9, 10, 15, 16 Township 35, North, Range 11 East, Fourth Principal Meridian, as described hereon; and that from this evidence I established a new monument and accessories as described hereon to perpetuate the original location of this corner.

Resident witnesses:


Glen Barker

Jlm Clafin

Herb Wagoner

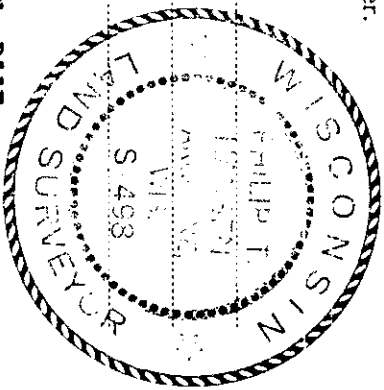

T35N R11E

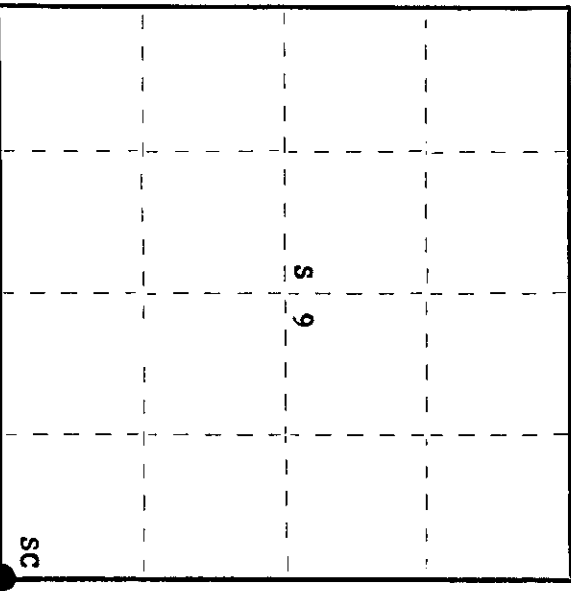

○ = Corner monument restored.

History of original corner establishment:

Original corner established by Wm. E. Dougherty, Deputy Surveyor, in 1859, from which White Pine 10" bears N73°E, 8 links and White Pine 8" bears S38°W, 10 links. H.C. Lawrence, Registered Land Surveyor, recovered an old stake here in 1953 and someone's old BT, white pine 24" bearing S15°E, 56 links.

Set new post and notes call for marking NBT's - Yellow Birch 18" S56½°E, 26 links and Maple 8" S41°W, 37 links.

Description of corner evidence found:

Recovered Lawrence's 6" cedar post, squared and scribed S9, S10, S15, S16, in poor condition. Recovered OBT - White Pine 26" S8°E, 56.8 links, scribed S15 BT. No evidence of Yellow Birch 18" or Maple 8" found. Believe these to have been an error in his notes.

Description of monument and accessories I established to perpetuate the original location of this corner.

Replaced 6" cedar post with 2½" Bertensen A-1 Federal Monument (O.C.), projecting 12" above ground. Cap stamped:

Marked NBT's - Black Spruce 6" S40°W, 32.2 links, S498  
 Red Pine 10" S57°E, 37.4 links, T35N  
 Maple 8" N37°W, 4.1 links, 9+10  
 all scribed SC BT. Sec. 16+15  
 R11E 1978

Dated at Rhinelander, Wis., this 13th day of January, 1978

Signature Phillip T. Hansen Title Registered Land Surveyor Registration No. S-498  
 (County Surveyor, Registered Land Surveyor, or other duly authorized official)

Office of Register of Deeds, County of Oneida  
 Instrument was filed in this office for record on the 30th day of January, 1978  
 at 4:45 o'clock P. M.

Dorcas Verne Kuhn  
 (Register of Deeds)

By \_\_\_\_\_ Deputy

3511090000