

CERTIFIED LAND CORNER RESTORATION



Index No. J-11

State of Wisconsin }
County of Oneida } ss.

I Phillip T. Hansen, do hereby certify that on the 10th day of May, 1978, I ~~have~~ established the Quarter corner of Section 9 & 16 Township 35 North, Range 11 East, Fourth Principal Meridian,

as described hereon; and that from this evidence I established a new monument and accessories as described hereon to perpetuate the original location of this corner.

Resident witnesses:
Glen Barker
Jim Claflin
Herb Wagoner

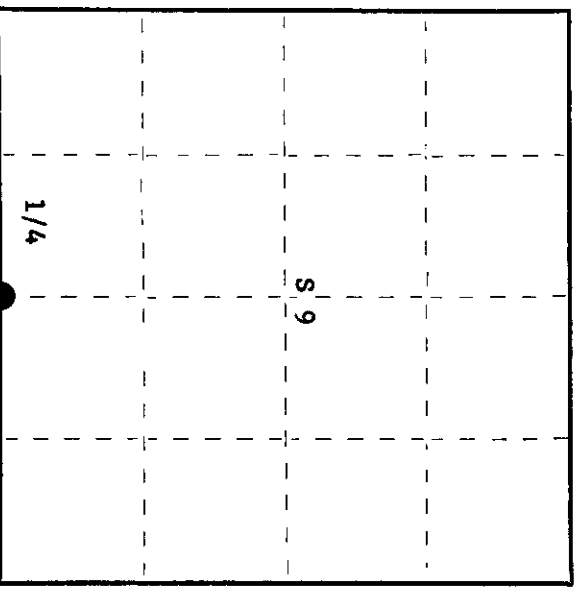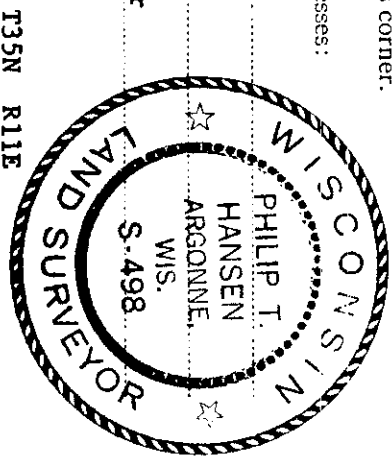

2629.266 2711.652
O = Corner monument restored.

History of original corner establishment:

Original corner established by Wm. E. Dougherty, Deputy Surveyor, in 1859 from which Fir 10" bears S 47° E, 38 links and Alder 10" bears N 68° W, 23 links.

Description of corner evidence found:

Corner established by traverse and computation and centerline of Stockley Melster Road. Ran traverse from section corner 8, 9, 16 and 17 to section corner 9, 10, 15 and 16. Computed distance is 5340.878 feet at bearing N 88° 55' 14" E. Set 1/4 corner on line and in centerline of Stockley Melster Road. 1/4 corner sets 2629.266 feet N 88° 55' 14" E of section corner 8, 9, 16 and 17 and 2711.652 feet S 88° 55' 14" W of section corner 9, 10, 15 and 16.

Description of monument and accessories I established to perpetuate the original location of this corner.

Drove a 1 1/2" x 18" iron pipe in centerline of Stockley Melster Road for true corner, 6" below surface.
Set a 2 1/2" Oneida County iron pipe with brass cap east for

witness corner, stamped:
Marked NBF's to true corner -
Black Spruce 7" S72°E, 40.45 feet
White Birch 8" S52°E, 55.49 feet
Red Pine 14" S37°E, 58.48 feet
S498
T35N R11E
1/4 S 1/16 W.C.
W. 45 ft. to cor.
CPI-1978

Dated at Rhineland, Wis., this 19th day of May, 1978

Signature Phillip T. Hansen Title Registered Land Surveyor Registration No. S-498
(County Surveyor, Registered Land Surveyor, or other duly authorized official)

Office of Register of Deeds, County of Oneida
at 100 o'clock P M. I hereby certify that the within instrument was filed in this office for record on the 29th day of May, 1978

Doree George Fuchs
(Register of Deeds)

By: _____ Deputy

3511090020