



CERTIFIED LAND CORNER RESTORATION

Index No. J-10

State of Wisconsin }  
County of Oneida } ss.

I, Phillip T. Hansen, do hereby certify that on the 15th day of May, 19 78, I ~~marked~~ established ~~corners of the~~ W 1/16 corner of Sections 9 & 16 Township 35, North, Range 11 East, Fourth Principal Meridian, as described hereon; and that from this evidence I established a new monument and accessories as described hereon to perpetuate the original location of this corner.

Resident witnesses:  
Glen Barker  
Jim Claflyn  
Herb Wagoner

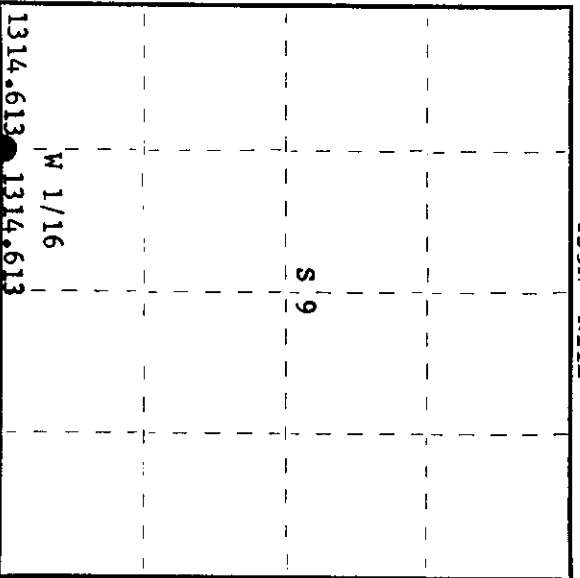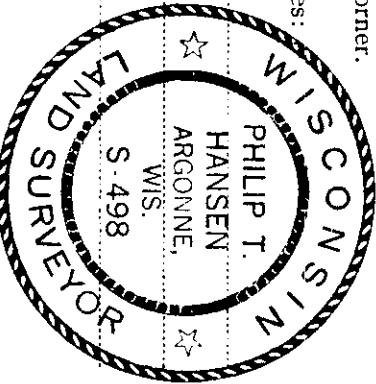

O = Corner monument restored.

History of original corner establishment:  
**No record of any previous survey.**

Description of corner evidence found:

**No evidence of any corner recovered.**  
Corner established by traverse and computation. Ran traverse west from previously established S 1/4 corner to section corner 8, 9, 16 & 17. Computed distance 2629.226 feet at bearing S 88° 55' 14" E. Set west 1/16 at 1314.613 feet intermediate.

Description of monument and accessories I established to perpetuate the original location of this corner.

Drove 1 1/2" x 18" iron pipe in position in centerline of old section line road for true corner, 5" below surface of road.  
Set 1 1/2" iron pipe with 2" brass cap 13' south for witness corner.  
Monument projects 18" above ground. Cap stamped:  
Marked NBT's from true corner.  
Sugar 10" S55°W, 79.80 feet  
Maple 7" S52°W, 47.95 feet, scribed 1/16 BT.

S498  
T35N R11E  
W 1/16 S 1/16 W.C.  
N 13 ft.  
1978

Dated at Rhinelander, Wis., this 30th day of May, 19 78

Signature: Phillip T. Hansen Title Registered Land Surveyor Registration No. S-498  
(County Surveyor, Registered Land Surveyor, or other duly authorized official)

Office of Register of Deeds, County of Oneida  
Instrument was filed in this office for record on the 13th day of June, 19 78  
at 2:30 o'clock P. M. I hereby certify that the within

David George Keck  
(Register of Deeds)

By Joseph M. Bann Deputy

3511090030