



CERTIFIED LAND CORNER RESTORATION

Index No. H-11

State of Wisconsin }
County of Oneida } ss.

I, Phillip T. Hansen, do hereby certify that on the 10th day of May, 1978, I have re-established the SC 1/16 corner of Section 9, Township 35, North, Range 11 East, Fourth Principal Meridian, as described hereon; and that from this evidence I established a new monument and accessories as described hereon to perpetuate the original location of this corner.

Resident witnesses:
Glen Barker
Jim Clafflin
Herb Wagoner

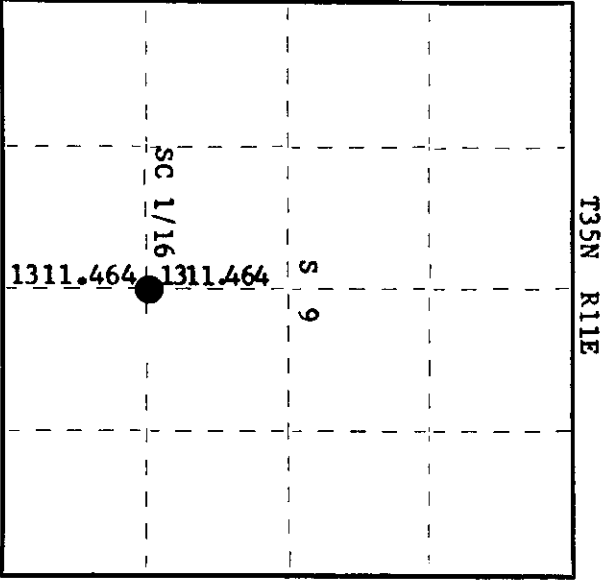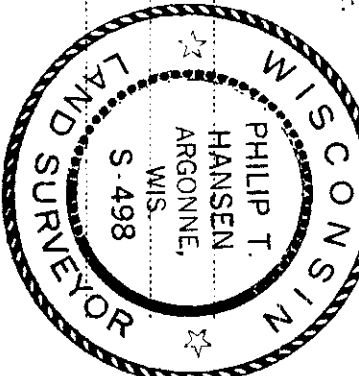

History of original corner establishment:
No evidence of corner found.

Description of corner evidence found:
Corner established by subdivision from traverse computation. From S 1/4 corner to previously established C 1/4 corner. Computed distance is 2622.928 feet at bearing N 0° 39' E. Set SC 1/16 at 1311.464 feet intermediate.

Description of monument and accessories I established to perpetuate the original location of this corner.
Drove a 1 1/2" x 18" iron pipe in east shoulder of Stockley Melster Road for true corner, 5" below surface.
Set a 1 1/2" iron pipe with 2" brass cap 20 feet east for witness corner. Cap stamped: S498
Projects 20" above ground T35N R11E
Marked NBT's to true corner - White Birch 6" N46°E 39.55 feet
scribed 1/16 BT SC 1/16 S 9 W.C.
Power pole #3511 - 9R5 S20°E, 28.95 feet W 20 ft. CPI-1978

Dated at Rhineland, Wis., this 19th day of May, 1978.

Signature Phillip T. Hansen Title Registered Land Surveyor Registration No. S-498
(County Surveyor, Registered Land Surveyor, or other duly authorized official)

Office of Register of Deeds, County of Oneida. I hereby certify that the within instrument was filed in this office for record on the 30th day of May, 1978 at 10:00 o'clock P. M.

Dorcas George Fischer
(Register of Deeds)

By: _____ Deputy

3511091020