

CERTIFIED LAND CORNER RESTORATION

Index No. **G-11**



State of Wisconsin

County of Oneida

} ss.

I Phillip T. Hansen, do hereby certify that on the 10th day of May, 1978, I ~~restored~~ established the C 1/4 corner of Section 9 Township 35, North, Range 11 East, Fourth Principal Meridian, as described hereon; and that from this evidence I established a new monument and accessories as described hereon to perpetuate the original location of this corner.

Resident witnesses:  
Glen Barker  
Jim Clafflin  
Herb Wagoner

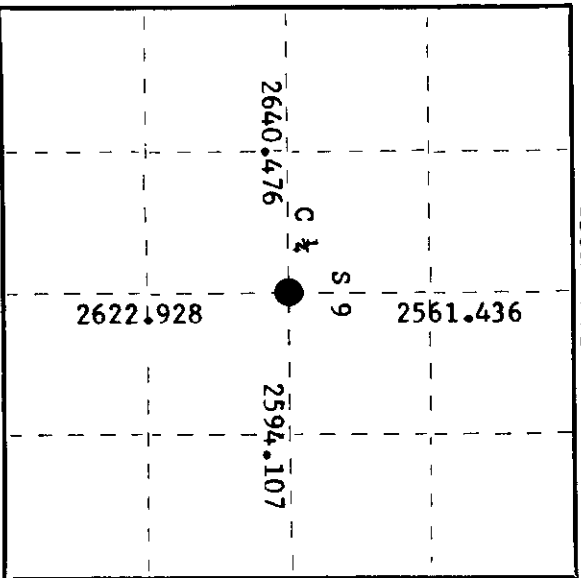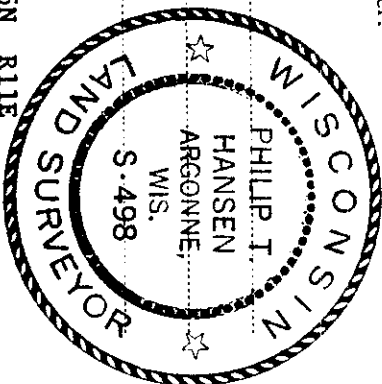

○ = Corner monument restored.

History of original corner establishment:  
**No evidence of any corner found.**

Description of corner evidence found:

**Corner established by traverse and computation. Ran traverse from N 1/4 corner to S 1/4 corner, section 9. Ran traverse from W 1/4 corner to E 1/4 corner section 9 to establish C 1/4 corner.**  
Corner sets 2561.436 feet S 0° 39' W of N 1/4 corner  
Corner sets 2622.928 feet N 0° 39' E of S 1/4 corner  
Corner sets 2640.476 feet N 88° 25' 18" E of W 1/4 corner  
Corner sets 2594.107 feet S 88° 25' 18" W of E 1/4 corner

Description of monument and accessories I established to perpetuate the original location of this corner.

**Set a 2 1/2" iron pipe with brass cap, cap stamped:  
Pipe projects 30" above ground.**  
Marked NBT's -  
Tamarack 6" S25° E, 21.7 feet  
Tamarack 8" S2° W, 27.35 feet  
Black Spruce 6" N48° W, 34.35 feet  
all scribed C 1/4 BT

Dated at Rhinelander, Wis., this 19th day of May, 1978

Signature Phillip T. Hansen Title Registered Land Surveyor Registration No. S-498  
(County Surveyor, Registered Land Surveyor, or other duly authorized official)

Office of Register of Deeds, County of Oneida  
Instrument was filed in this office for record on the 23rd day of May, 1978  
at 1:00 o'clock P. M.

Donie George Kuehn  
(Register of Deeds)

By: \_\_\_\_\_ Deputy

3511092020