

CERTIFIED LAND CORNER RESTORATION

Index No. F-11

State of Wisconsin

County of Oneida } ss.

History of original corner establishment:

I, Phillip T. Hansen, do hereby

certify that on the 10th day

~~established~~ re-established the NC 1/16

corner of Section 9

Township 35, North, Range

11 East, Fourth Principal Meridian,

as described hereon; and that from this evidence

I established a new monument and accessories

as described hereon to perpetuate the original


location of this corner.

Resident witnesses:

Glen Barker

Jim Claffin

Herb Wagoner

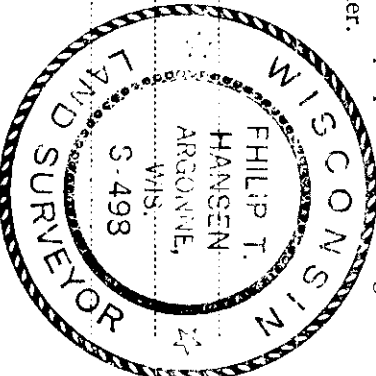

No record of any previous survey.

Description of corner evidence found:

No evidence of any corner recovered.

Corner established by traverse and computation. From previously established 1/4 corner

ran the East-West 1/4 line and the N-S 1/4 line to establish the C 1/4. C 1/4 corner sets

2561.436 feet, S 0° 39' W of the N 1/4 corner.

Set the NC 1/16 at 1280.718 feet intermediate.

Description of monument and accessories I established to perpetuate the original location of this corner.

Set a 1 1/2" iron pipe with 2" brass cap, stamped:

Monument projects 18" above ground.

Marked NBT's -

Black Spruce 5" N23°W, 65.80 feet

Black Spruce 3" N66°E, 22.70 feet, scribed 1/16 BT.

S498
T35N R11E
NC 1/16 S+9
CPI-1978

Dated at Rhineland, Wis., this 30th day of May, 19 78

Signature: Phillip T. Hansen Title Registered Land Surveyor Registration No. S-498

(County Surveyor, Registered Land Surveyor, or other duly authorized official)


Office of Register of Deeds, County of Oneida

Instrument was filed in this office for record on the 13th day of June, 19 78

at 2:30 o'clock P. M. I hereby certify that the within

Darin Savage (Register of Deeds)

By Joseph M. Barner Deputy

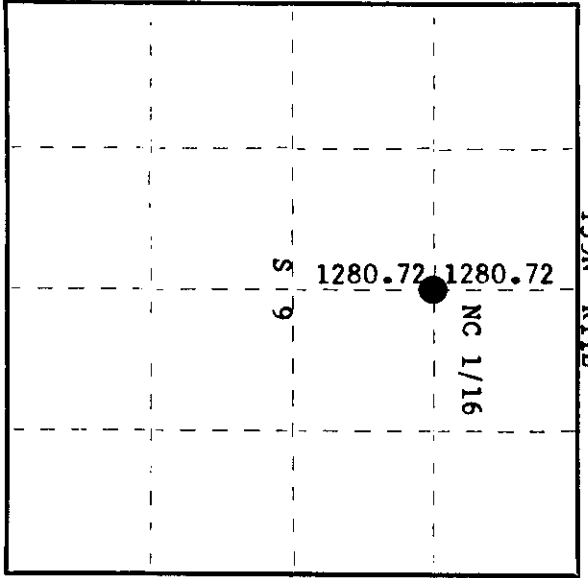

O = Corner monument restored.

3511093020