

CERTIFIED LAND CORNER RESTORATION

Index No. J-17

State of Wisconsin }
County of Oneida } ss.


I Philip T. Hansen, do hereby certify that on the 12th day of October, 1976, I found evidence of the Section corner of S10, 11, 15, 14 Township 35, North, Range 11 East, Fourth Principal Meridian, as described hereon; and that from this evidence I established a new monument and accessories as described hereon to perpetuate the original location of this corner.

Resident witnesses:

Glen Barker


Jim Claflin

Herb Wagoner

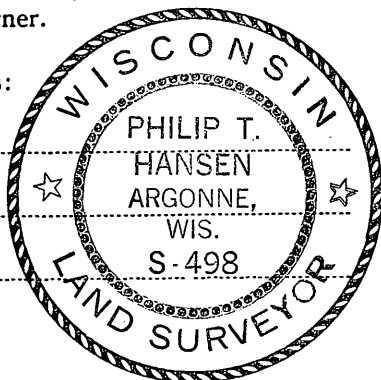

FORM 985
Wisconsin Planning & Surveying Co.
Milwaukee, Wisconsin

T35N R11E

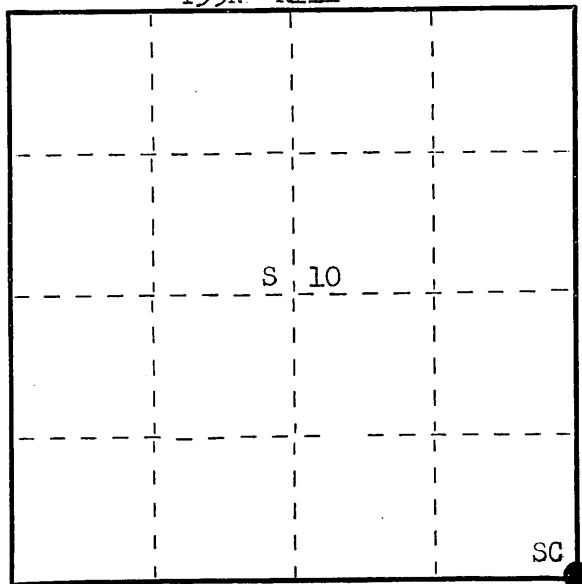

○ = Corner monument restored.

History of original corner establishment:

Original Corner established by Wm. E. Dougherty, Deputy Surveyor, in 1859; from which White Pine 10" bears S 85° W 110 links and Tamarack 8" bears N 80° W 116 links.

H. C. Lawrence, Registered Land Surveyor, recovered a 4" Tamarack post in 1954. This sets in an open muskeg marsh. An iron sleigh runner shoe sets beside the post. Recovered stump of original White Pine S 85° W 110 links, scribe marks visible. The tamarack BT was gone. Set new post.

Description of corner evidence found:

Recovered 4" tamarack post, squared and scribed S10, S11, S14, S15, in fair condition. Recovered an old 6 1/2' sleigh runner beside it. Recovered OBT (original) White Pine 10" stump S 85° W 110 links, scribing still visible.

Description of monument and accessories I established to perpetuate the original location of this corner.

Replaced 4" tamarack post with 2 1/2" Berntsen A-1 Federal Monument, aluminum with magnet installed in cap and base. Monument projects 24" above ground. Cap stamped:
NBTs - Black Spruce 8" S 53° W 2.601 chains scribed SC BT.
White Spruce 10" N 11° W 2.514 chains, scribed SC BT.
White Birch 6" N 29° W 2.059 chains, scribed SC BT.

T35N R11E
Sec. 10 | 11
15 | 14
S498-1976

Dated at Rhineland, Wis., this 24th day of November, 1976

Signature Philip T. Hansen Title Registered Land Surveyor Registration No. S-498
(County Surveyor, Registered Land Surveyor, or other duly authorized official)

Office of Register of Deeds, County of Oneida. I hereby certify that the within instrument was filed in this office for record on the 7th day of December, 1976 at 11:00 o'clock a M.

Doris Verage Kuehn
(Register of Deeds)
By Joseph M. Boomer Deputy

351100000