

CERTIFIED LAND CORNER RESTORATION

Index No. V-15


State of Wisconsin


I, Philip T. Shannon, do hereby certify that on the 11th day of October, 1976, I found evidence of the original corner of Section 10 and 15 Township 35, North, Range 11, Fourth Principal Meridian, as described hereon; and that from this evidence I established a new monument and accessories as described hereon to perpetuate the original location of this corner.

Resident witnesses:

John J. ...
...
...

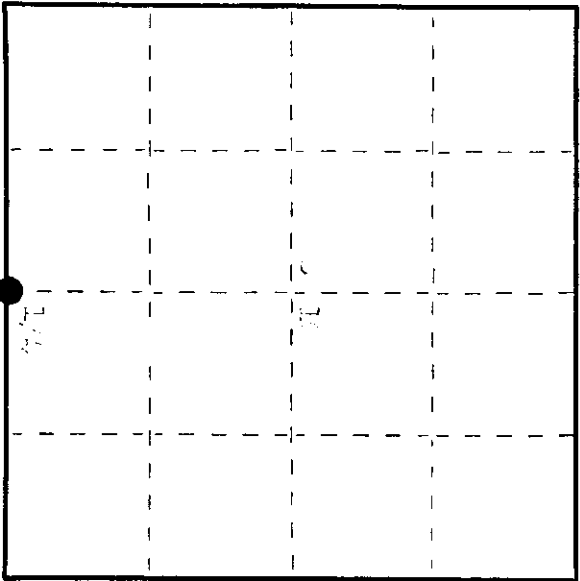

○ = Corner monument restored.




Description of corner evidence found:


Description of monument and accessories I established to perpetuate the original location of this corner.





Signature Philip T. Shannon Title County Surveyor, Registered Land Surveyor, or other duly authorized official Registration No. 478


By Daniel George Kuehn (Register of Deeds) Deputy

3511100020