

CERTIFIED LAND CORNER RESTORATION

Index No. H-17

State of Wisconsin

County of Oneida } ss.

I Phillip T. Hansen, do hereby certify that on the 10th day of May, 1977, I ~~restored~~ restored established the S 1/16 corner of Section 10 & 11, Township 35, North, Range 11 East, Fourth Principal Meridian,



as described hereon; and that from this evidence I established a new monument and accessories as described hereon to perpetuate the original location of this corner.

Resident witnesses:

Glen Barker

Jim Claffin

Herb Wagoner

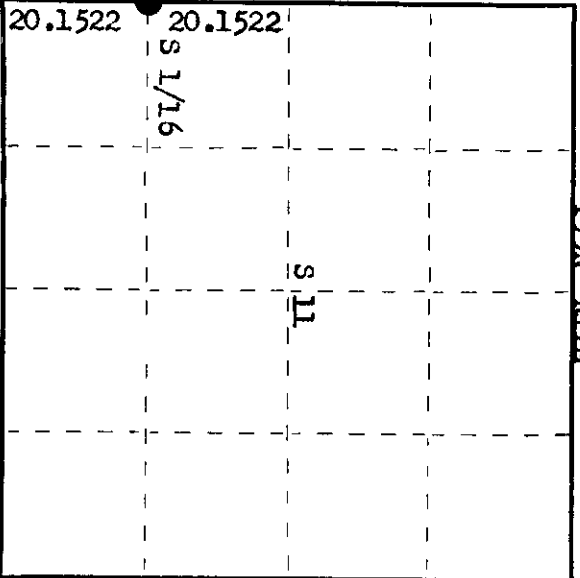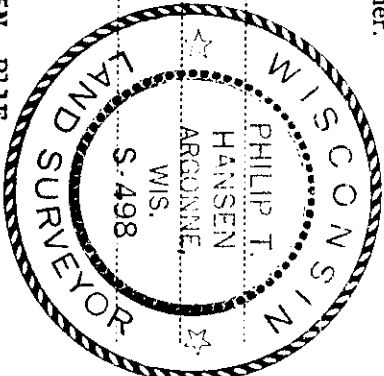

○ = Corner monument restored.

History of original corner establishment:

Corner established by traverse and computed distance from recovered  $\frac{1}{4}$  corner and Section Corner 10, 11, 14, 15. Computed distance 40.304 chains bearing N 0 22' 28" E. Set corner at 20.1522 chains, equidistant.

This corner had been established by H.C. Lawrence, Registered Land Surveyor, in 1954, when he ran a random line south from recovered  $\frac{1}{4}$  corner between Sec. 10 & 11. Computed distance is .0278 chains or 1.83 ft. north of section corner.

Description of corner evidence found:

Recovered H.C. Lawrence's corner 1.83 ft. south of computed location.  
Recovered Lawrence's dead tamarack BT 10"

Description of monument and accessories I established to perpetuate the original location of this corner.

Set a  $\frac{1}{2}$ " iron pipe with 2" brass cap for computed corner which was removed from its former location.

Monument projects 24" above ground. Cap stamped:  
Marked NBTs - Black Spruce 6" S35°E, 17 links, scribed 1/16 BT. S498 T35N R11E  
Black Spruce 8" S42°W, 32 links, scribed 1/16 BT.  
H.C. Lawrence's Tamarack 10" (dead) N48°E, 84.8 links, S 1/16 S10°S11

S498 T35N R11E  
S10°S11  
CPL-1977

Dated at Rhineland, Wis., this 13th day of May, 1977.

Signature: Phillip T. Hansen Title: Registered Land Surveyor Registration No. S-498  
(County Surveyor, Registered Land Surveyor, or other duly authorized official)

Office of Register of Deeds, County of Oneida, I hereby certify that the within instrument was filed in this office for record on the 16th day of May, 1977 at 10:30 o'clock P. M.

Doris Neuge Kuehn  
(Register of Deeds)

By: \_\_\_\_\_ Deputy

3511101000