

CERTIFIED LAND CORNER RESTORATION



Index No. H-15

State of Wisconsin

County of Oconto } ss.

I, John J. Brown, do hereby certify that on the 19th day of September, 1976, I found evidence of the SE 1/4 corner of Section 10 Township 35, North, Range 11, 4th Principal Meridian, as described hereon; and that from this evidence I established a new monument and accessories as described hereon to perpetuate the original location of this corner.

Resident witnesses:

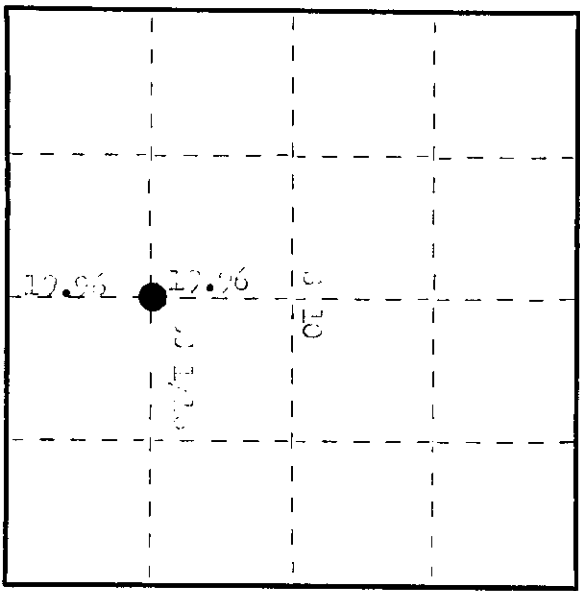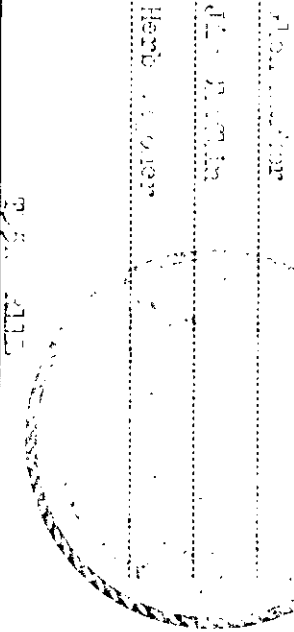

○ = Corner monument restored.

CERTIFIED LAND CORNER RESTORATION

History of original corner establishment:


Description of corner evidence found:

Description of monument and accessories I established to perpetuate the original location of this corner:

Dated at Oconto, Wis., this 19th day of November, 1976.

Signature John J. Brown Title Registered Land Surveyor or other duly authorized official Registration No. 4430

Office of Register of Deeds, County of Oconto.
I hereby certify that the within instrument was filed in this office for record on the 19th day of December, 1976 at 11:00 o'clock A. M.

By James George Kuehn (Register of Deeds)
Speckle M. Brown Deputy

51-270

3511101020