



CERTIFIED LAND CORNER RESTORATION

Index No. **F-21**

State of Wisconsin }  
 County of Oneida } ss.

I Phillip T. Hansen do hereby certify that on the 11th day of July 1975 I found evidence of the N-1/16 corner of Sections 11 and 12 Township 35 North, Range 11, East Fourth Principal Meridian, as described hereon; and that from this evidence I established a new monument and accessories as described hereon to perpetuate the original location of this corner.

Resident witnesses:

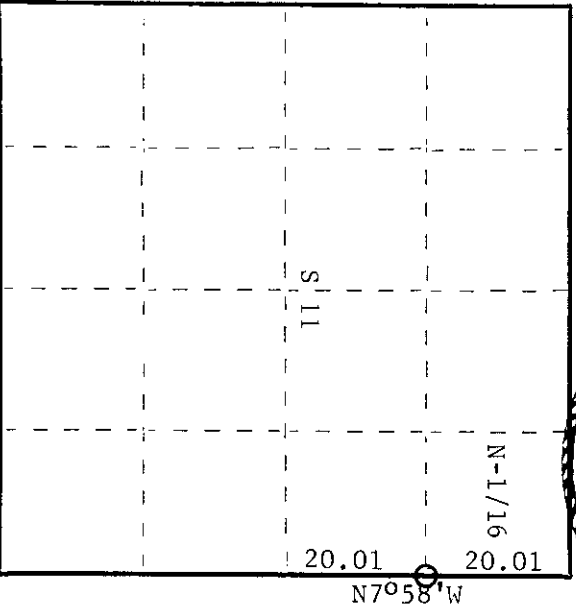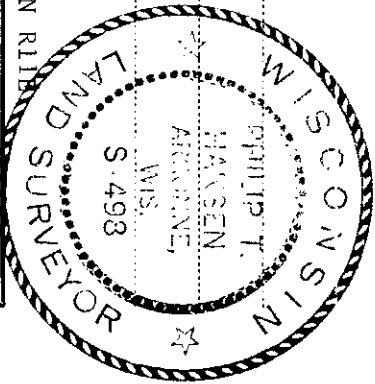

○ = Corner monument restored.


History of original corner establishment:

Original corner established by D.H. Vaughan, County Surveyor, in 1914. Set post, from which sugar 14" bears N36°W 44 links, and sugar 18" bears S71½°E 39 links. Recovered by H.C. Lawrence, Registered Land Surveyor, in 1958. From E½ corner he ran a random line N7°00'W (mag.) a distance of 40.02 chains to point 68 links east of section corner. Corrected bearing N7°58'W. At 20.01 chains, he offset west 34 links at which point he found Vaughan's post lying on the ground and found very rotted stumps of BT's at course and distance called for. Lawrence set 4" cedar post for N-1/16 corner and made NBT's - white birch 8" N26°E 30 links, and elm 4" S52°W 13 links. Description of corner evidence found:  
 Recovered 4" cedar post, squared and scribed N-1/16 S11, N-1/16 S12, in good condition.  
 Recovered OBT's - elm 4" S52°W (S62°W) 13 links, scribing grown over.  
 White birch 8" (9") N26°E 20 links, scribed N-1/16 NBT.

Description of monument and accessories I established to perpetuate the original location of this corner.

Replaced 4" cedar post with 1½" O.D. iron pipe with 2" brass cap stamped -

NBT - white birch 9" S36°E 36 links, scribed 1/16 BT.

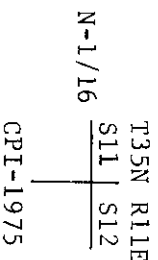

Dated at Rhinelanders Wis. this 24th day of July 1975.

Signature *Phillip T. Hansen* Title Reg. Land Surveyor Registration No. S-498  
 (County Surveyor, Registered Land Surveyor, or other duly authorized official)

Office of Register of Deeds, County of Oneida at *1st* day of *October* 1975  
 at *3:00* o'clock *PM*. I hereby certify that the within

Signature *Lorna Verage Fuchs*  
 (Register of Deeds)

By Deputy

351113000