

CERTIFIED LAND CORNER RESTORATION



Index No. **J-22**

State of Wisconsin

County of Oneida } ss.

I Philip T. Hansen do hereby certify that on the 10th day of May, 1975, I found evidence of the W-1/16 between corner of Sections 12 and 13 Township 35 North, Range 11 East, Fourth Principal Meridian, as described hereon; and that from this evidence I established a new monument and accessories as described hereon to perpetuate the original location of this corner.

Resident witnesses:

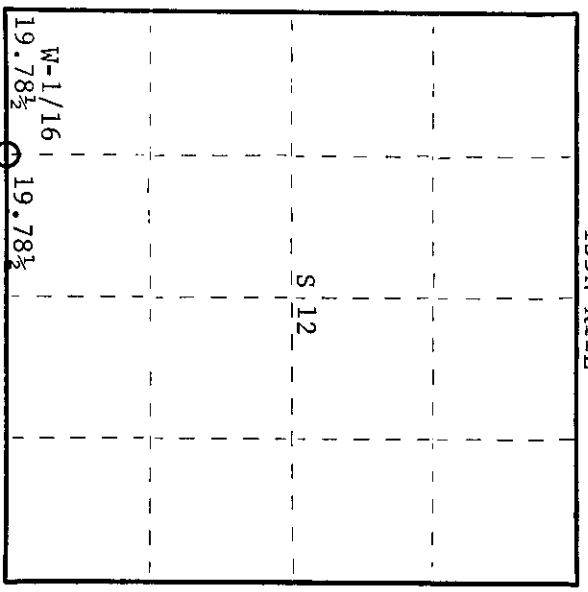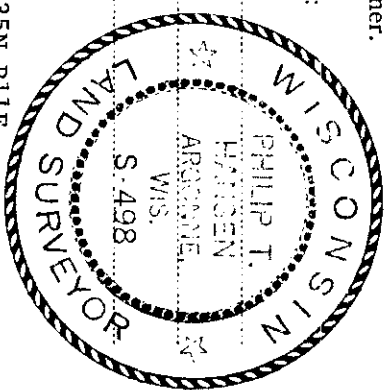

○ = Corner monument restored.

History of original corner establishment:

Corner established by H.C. Lawrence, Registered Land Surveyor, in 1959. Set W-1/16 corner equidistant between 1/4 corner and Section Corner S12, S13, S14, S11, at 19.78-1/2 chains east of corner. Stake was offset to the south side of road.

Established BT's: Elm 15" S50°E 77 links and Basswood 9" S66°W 59 links.

Description of corner evidence found:

Recovered 4" cedar post, squared and scribed W-1/16 S12, W-1/16 S13 offset to south side of road. No mention in notes as to correct distance of offset.

Recovered elm BT, scribing grown over. Basswood BT now broken off and dead.

Description of monument and accessories I established to perpetuate the original location of this corner.

Set 1-1/2" x 18" iron pipe on line between 1/4 corner and Section Corner, flush with the ground. Set 1-1/2" OD iron pipe 15 links south at right angles. Pipe has 2" brass cap stamped -

Established NBT's: Elm 6" S20°W 76.3 links scribed 1/16 BT W-1/16 S 1/12  
Elm 10" N68°E 108 links scribed 1/16 BT. S 1/13

Measurements made to true corner.

CPI-1975 W.C. N 15 Lks

Dated at Rhineland, Wis. this 10th day of May, 1975

Signature *Philip T. Hansen* Title Registered Land Surveyor Registration No. S-498  
(County Surveyor, Registered Land Surveyor, or other duly authorized official)

Office of Register of Deeds, County of Oneida  
at 3:00 o'clock P.M. I at day of October, 1975

*Dorothy Verge Fuchs*  
(Register of Deeds)

By: Deputy

351120030