


CERTIFIED LAND CORNER RESTORATION

Index No. H-23

State of Wisconsin }
 County of Oneida } ss.

I Philip T. Hansen, do hereby certify that on the 29th day of May, 1975, I found evidence of the SC-1/16 corner of Section 12 Township 11 East, North, Range 11 East, Fourth Principal Meridian, as described hereon; and that from this evidence I established a new monument and accessories as described hereon to perpetuate the original location of this corner.

Resident witnesses:

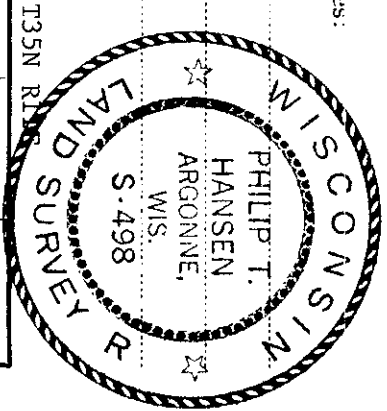

History of original corner establishment:
 Corner established by H.C. Lawrence, Registered Land Surveyor, in 1959. Set 4" cedar post equidistance at 19.06 chains north of S-1/4 post and 19.06 chains south of C-1/4 post, offset west of centerline of road 42 links. Established black cherry 6" S82°W 67-1/2 links from true corner and S67-1/2°W 27 links from offset post.

Description of corner evidence found:

Recovered 4" cedar post, squared and scribed SC-1/16 S12, SC-1/16, in poor condition. This is a W.C. 42 links west of true corner.

Recovered OBT - black cherry 6" (9") S82°W 67.5 links, scribing grown over. Reference to true corner.

Searched for iron pipe in the roadbed, from reference ties, but was unable to find any.


Description of monument and accessories I established to perpetuate the original location of this corner.

Replace 4" cedar post with 1-1/2" O.D. iron pipe with 2" brass cap stamped -

Set 1-1/2" O.D. x 18" pipe in road bed, flush with ground. S498 T35N R11E

NBT - elm 8" N47°W 72 links, scribed 1/16 BT. Referenced to SC-1/16 S 1/12 W 1/4 C. true corner.

E-42 links

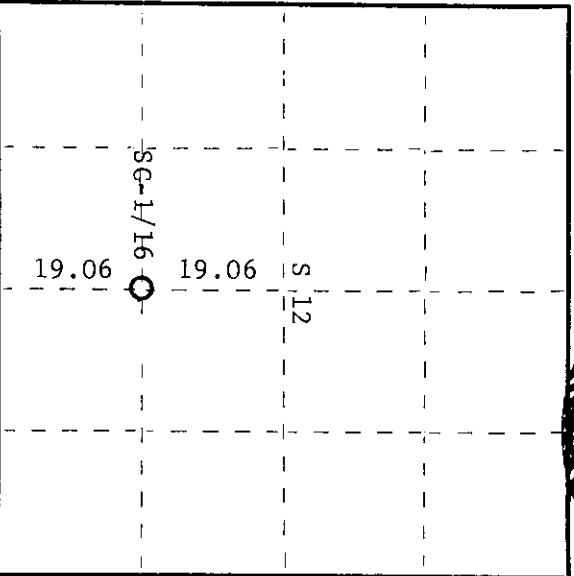

O = Corner monument restored.

Dated at Rhinelander, Wis., this 13th day of June, 1975.

Signature: *Philip T. Hansen* Title Registered Land Surveyor Registration No. S-498
 (County Surveyor, Registered Land Surveyor, or other duly authorized official)

Office of Register of Deeds, County of Oneida. I hereby certify that the within instrument was filed in this office for record on the 1st day of October, 1975, at 3:00 o'clock P.M.

Doris Savage Kuehn
 (Register of Deeds)

By: _____ Deputy

351121020