

CERTIFIED LAND CORNER RESTORATION

State of Wisconsin }
 County of Oneida } ss.

I, Philip T. Hansen do hereby certify that on the 29th day of August 1975, I found evidence of the W 1/16 corner of Sec 13 and 24 Township 35 North Range 11 East Fourth Principal Meridian, as described hereon; and that from this evidence I established a new monument and accessories as described hereon to perpetuate the original location of this corner:


Description of original monument and accessories and subsequent restorations: Corner established by D. Vaughan, County Surveyor in 1907, from which spruce 12" bears N 48° W 50 lks and W. Pine 16" bears N 14° E 62½ lks.

Corner recovered and restored by H.C. Lawrence, Reg. Land Surveyor in 1958. Found Vaughan's old post in fence line and recovered Vaughan's BTs - Spruce 12" N 48 W was down but scribe marks clearly visible. W. Pine N 14 E 62½ lks now a stump. Set new post from Vaughan's BTs which checked old post and marked NBTs - Maple 10" N83°W 18 lks and Maple 8" 53°W 14 lks.

Description of corner evidence found: Recovered Lawrence's 3" cedar post, squared and scribed W 1/16 S13, W 1/16 S 24 in fair condition, which was tied to a new fence. Some bulldozing had been done in old fence line to install new N-S fence. Recovered remains of Vaughan's Spruce BT. Lawrence's 8" maple had been bulldozed out. The maple 10" N83°W 18 lks was recovered.

Description of monument and accessories I established to perpetuate the location of this corner: Reestablished point of Lawrence's corner from his maple 10" N83°W and remains of Vaughan's Spruce stump. Set a 1½" iron pipe with 2" brass cap stamped.
 NBT - Red Maple 6" S 23°W 37.8 lks scribed 1/16 BT

S 498
 T 35 N R 11 E
 W 1/16 $\frac{S}{S}$ $\frac{13}{24}$
 CPI 1975

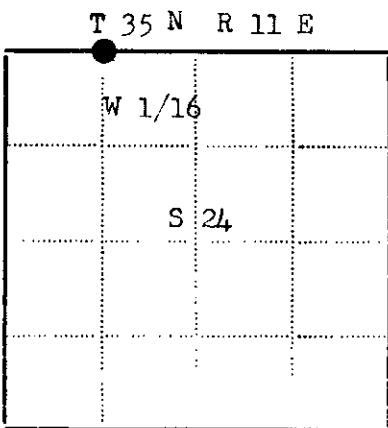

● - Corner monument restored
 □ -

Resident witnesses: Glen Barker and Jim Claflin

Dated at Rhineland Wisconsin, this 16th day of September 1975.

Signature: *Philip T. Hansen* Title: Reg. Land Surveyor
 (County Surveyor, Registered Land Surveyor, or other duly authorized official)

Surveyors Registration No. S 498

Office of Register of Deeds County of Oneida

I hereby certify that the within instrument was filed in this office for record on the 14th day of October 1975, and was filed in Book No. 7 Page No. of County Records.

Signature: *Doris Verage Kuehn* Title: Register of Deeds

Township 35 North Range 11 East Section 24 Index No. Page No.

351130030

N-22