

CERTIFIED LAND CORNER RESTORATION

Index No. L-222

State of Wisconsin


County of Oneida } ss.

I, Phillip T. Hansen, do hereby certify that on the 15th day of May, 1975, I found evidence of the WC-1/16 corner of Section 13

Township 35 North, Range 11 East, Fourth Principal Meridian,

as described hereon; and that from this evidence I established a new monument and accessories as described hereon to perpetuate the original location of this corner.

Resident witnesses:

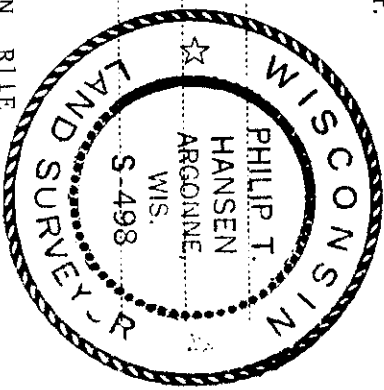

History of original corner establishment: Original subdivision of Section 13, but no mention made of establishing the WC-1/16 corner. Corner re-established by H.C. Lawrence, Registered Land Surveyor, in 1958, during his retracement survey. He ran the north-south 1/4 line and east-west 1/4 line and corrected same to establish C-1/4 section corner. He set his WC-1/16 corner at 19.16-1/2 chains N86°57'W of C-1/4 equidistant between C-1/4 and W-1/4 corners. Set 5" cedar post 40 links north of center line of Highway B.

Description of corner evidence found: Recovered 5" cedar post, squared and scribed WC-1/16 S13, WC-1/16 S13 in poor condition, with rock carron piled around it. A 1-1/2" iron pipe had been set beside stake.

No OBT's were recovered.

Description of monument and accessories I established to perpetuate the original location of this corner. Replaced wooden stake in rock carron with 1-1/2" O.D. iron pipe with 2" brass cap stamped - Placed additional stones around iron pipe.

Established NBT's - White birch 7" N27°E 65.5 links scribed 1/16 BT
 White birch 4" N85°W 43.2 links scribed 1/16 BT
 WC-1/16 S13
 T35N, R11E
 CP1-1975


Dated at Rhineland, Wis., this 4th day of June, 1975

Signature: *Phillip T. Hansen* Title: Registered Land Surveyor Registration No. S-498
 (County Surveyor, Registered Land Surveyor, or other duly authorized official)

Office of Register of Deeds, County of Oneida
 Instrument was filed in this office for record on the 1st day of October, 1975
 at 3:00 o'clock P.M.

Tonia Terage Fuchler
 (Register of Deeds)

By: Deputy

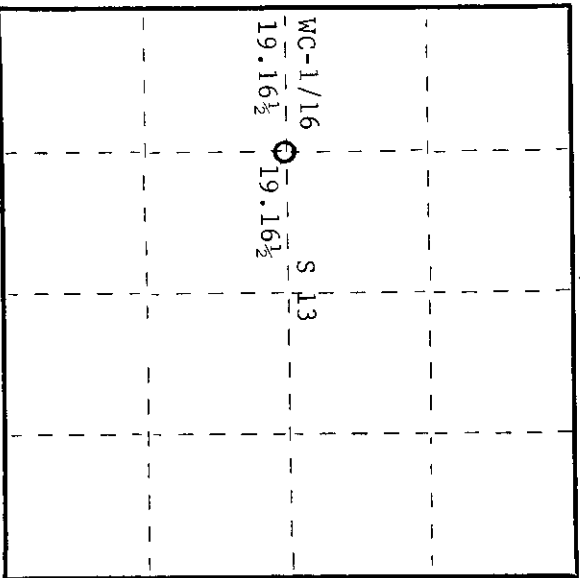

O = Corner monument restored.

351132030